


PROJECT: City of Dawson Production Wells		CLIENT: City of Dawson		HOLE NO: PW-4N			
LOCATION: Dawson City UTM N 576,099.5 E 7,104,358.7				PROJECT NO.: 5140579			
CONTRACTOR: MDS		METHOD: Air Rotary		GROUND ELEVATION (m): 320.25			
BACKFILL TYPE		☒ BENTONITE	☐ GRAVEL	☐ SLOUGH	☐ GROUT	☒ CUTTINGS	☐ SAND
DEPTH (m)	SOIL SYMBOL	SOIL DESCRIPTION			WELL INSTALLATION	COMMENTS	ELEVATION (m)
0		TOPSOIL, sandy loam, organics and rootlets.					320
1		FILL, fine SAND and SILT, light grey to light brown. Becomming coarse with depth.					319
2							318
3							317
4		SAND and GRAVEL, air blown fines with some cobbles present.					316
5							315
6		Cobbles in SAND and GRAVEL.					314
7		SAND and GRAVEL, wet, sub-rounded to sub-angular. Light brown, trace silt.					313
8							312
9							311
10							310
11							309
12							308
13							307
14							306
15							305
16							304
17							303
18							302
19							301
20		BEDROCK, greenstone and schist rock chips observed. end of hole					300
21							299
22							
					Well Screen Completion Details: Lenght: 3.35 m (11 ft) Diameter: 355 mm (14") OD Slot: 120-slot (3.048 mm) open area Material: Stainless Steel, v-wire continuous wrap construction See as-builts for additional details.		
					LOGGED BY: Caleb Light		COMPLETION DEPTH: 19.00 m
					REVIEWED BY: Jonathan Kerr		COMPLETION DATE: 15/07/14
					PROJECT ENGINEER: Jonathan Kerr		Page 1 of 1

BOREHOLE AND WELL LOG GINT-2014-08-19-DCPW BOREHOLE LOGS, CL-5140579.GPJ AECOM_BBY_2011.GDT 16/09/14

Well Screen Completion Details:
 Length: 3.35 m (11 ft)
 Diameter: 355 mm (14") OD
 Slot: 120-slot (3.048 mm) open area
 Material: Stainless Steel, v-wire continuous wrap construction
 See as-builts for additional details.

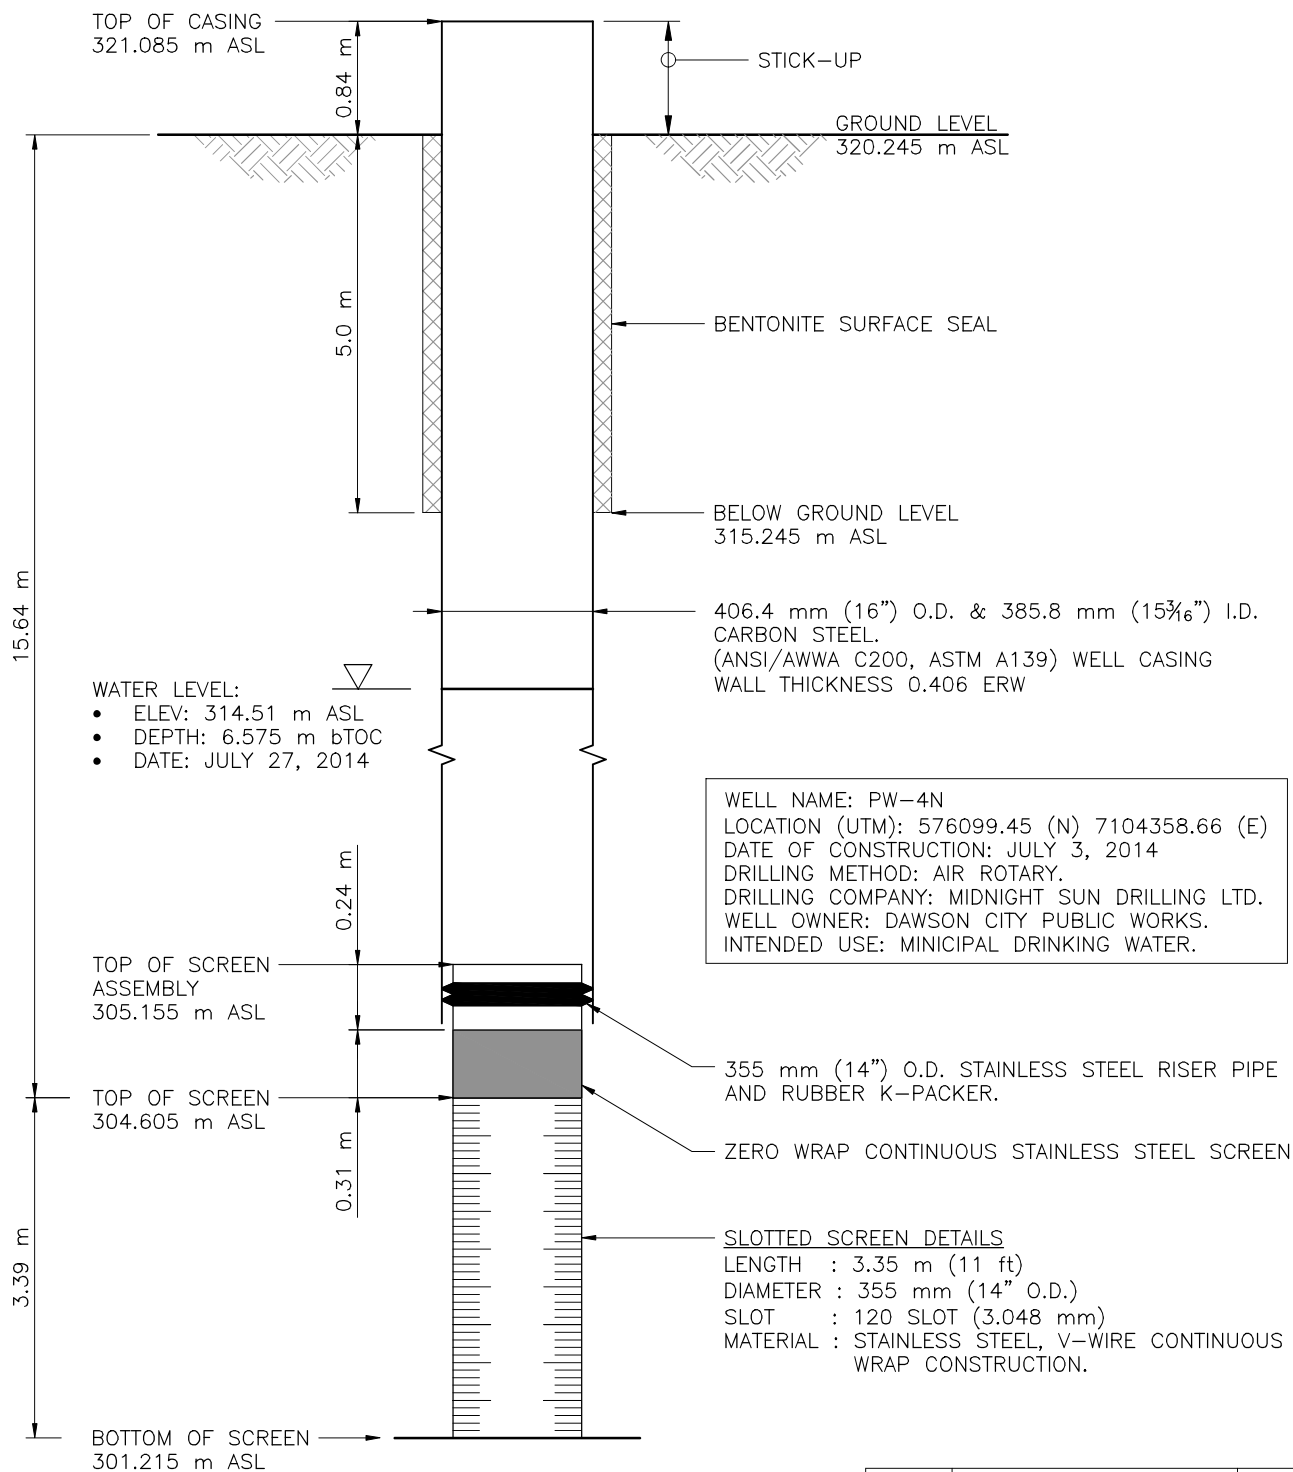

A	ISSUED FOR _____	YY-MM-DD
ISSUE	DESCRIPTION	DATE

Notes:

ID - INNER DIAMETER
 BTOC - BELOW TOP OF CASING
 ASL - ABOVE SEA LEVEL
 OD - OUTER DIAMETER

Client:



DAWSON CITY GROUNDWATER WELL CONSTRUCTION PW-4N

Project No.:

5140579.00

Drawing. No.

104



MORRISON HERSHFELD

Suite 310, 4321 Still Creek Dr,
 Burnaby, BC V5C 6S7
 www.morrisonhershfield.com
 Tel: 604 454 0402 Fax: 604 454 0403

Design

Drawn:

Reviewed:

Scale:

Date:

NTS

14-08-08