


000621

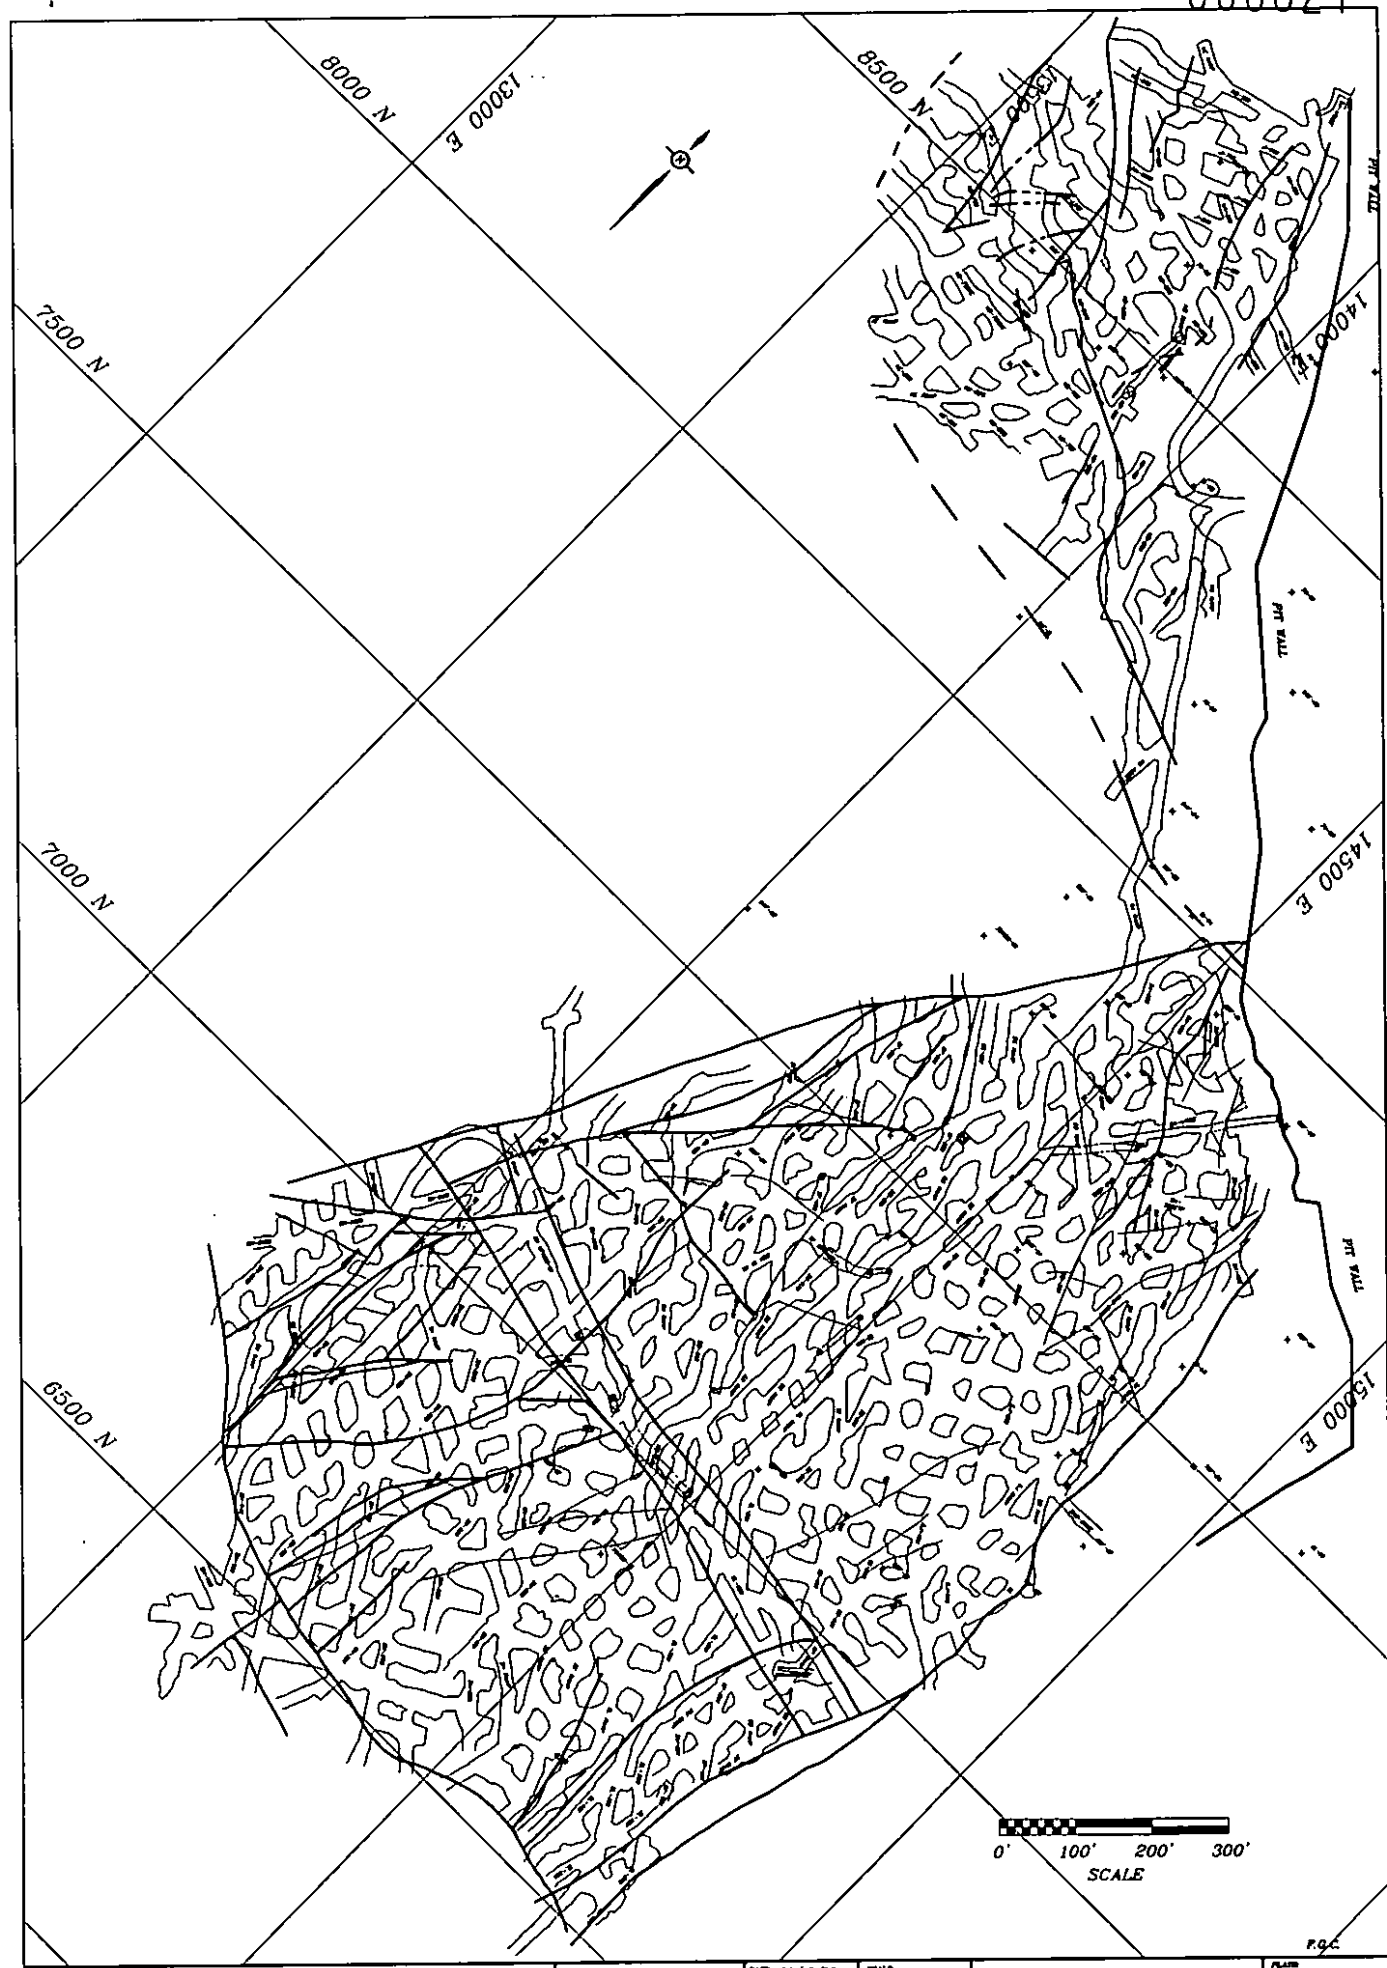


CURRAGH INC.

DESIGNED BY: L. DELQUIST, P.E.C.C.	DATE: 06/10/90	SCALE:
DRAWN BY: L. DELQUIST, P.E.C.C.	DATE: 04/10/92	1"=200'
FOR ASBUILT, DOH/STRUCT. TEMPLATE ACAD V. 11		


0' 100' 200' 300'
SCALE

FARO U/C MINE PLAN
TO SEPT 30, 1992

P.92

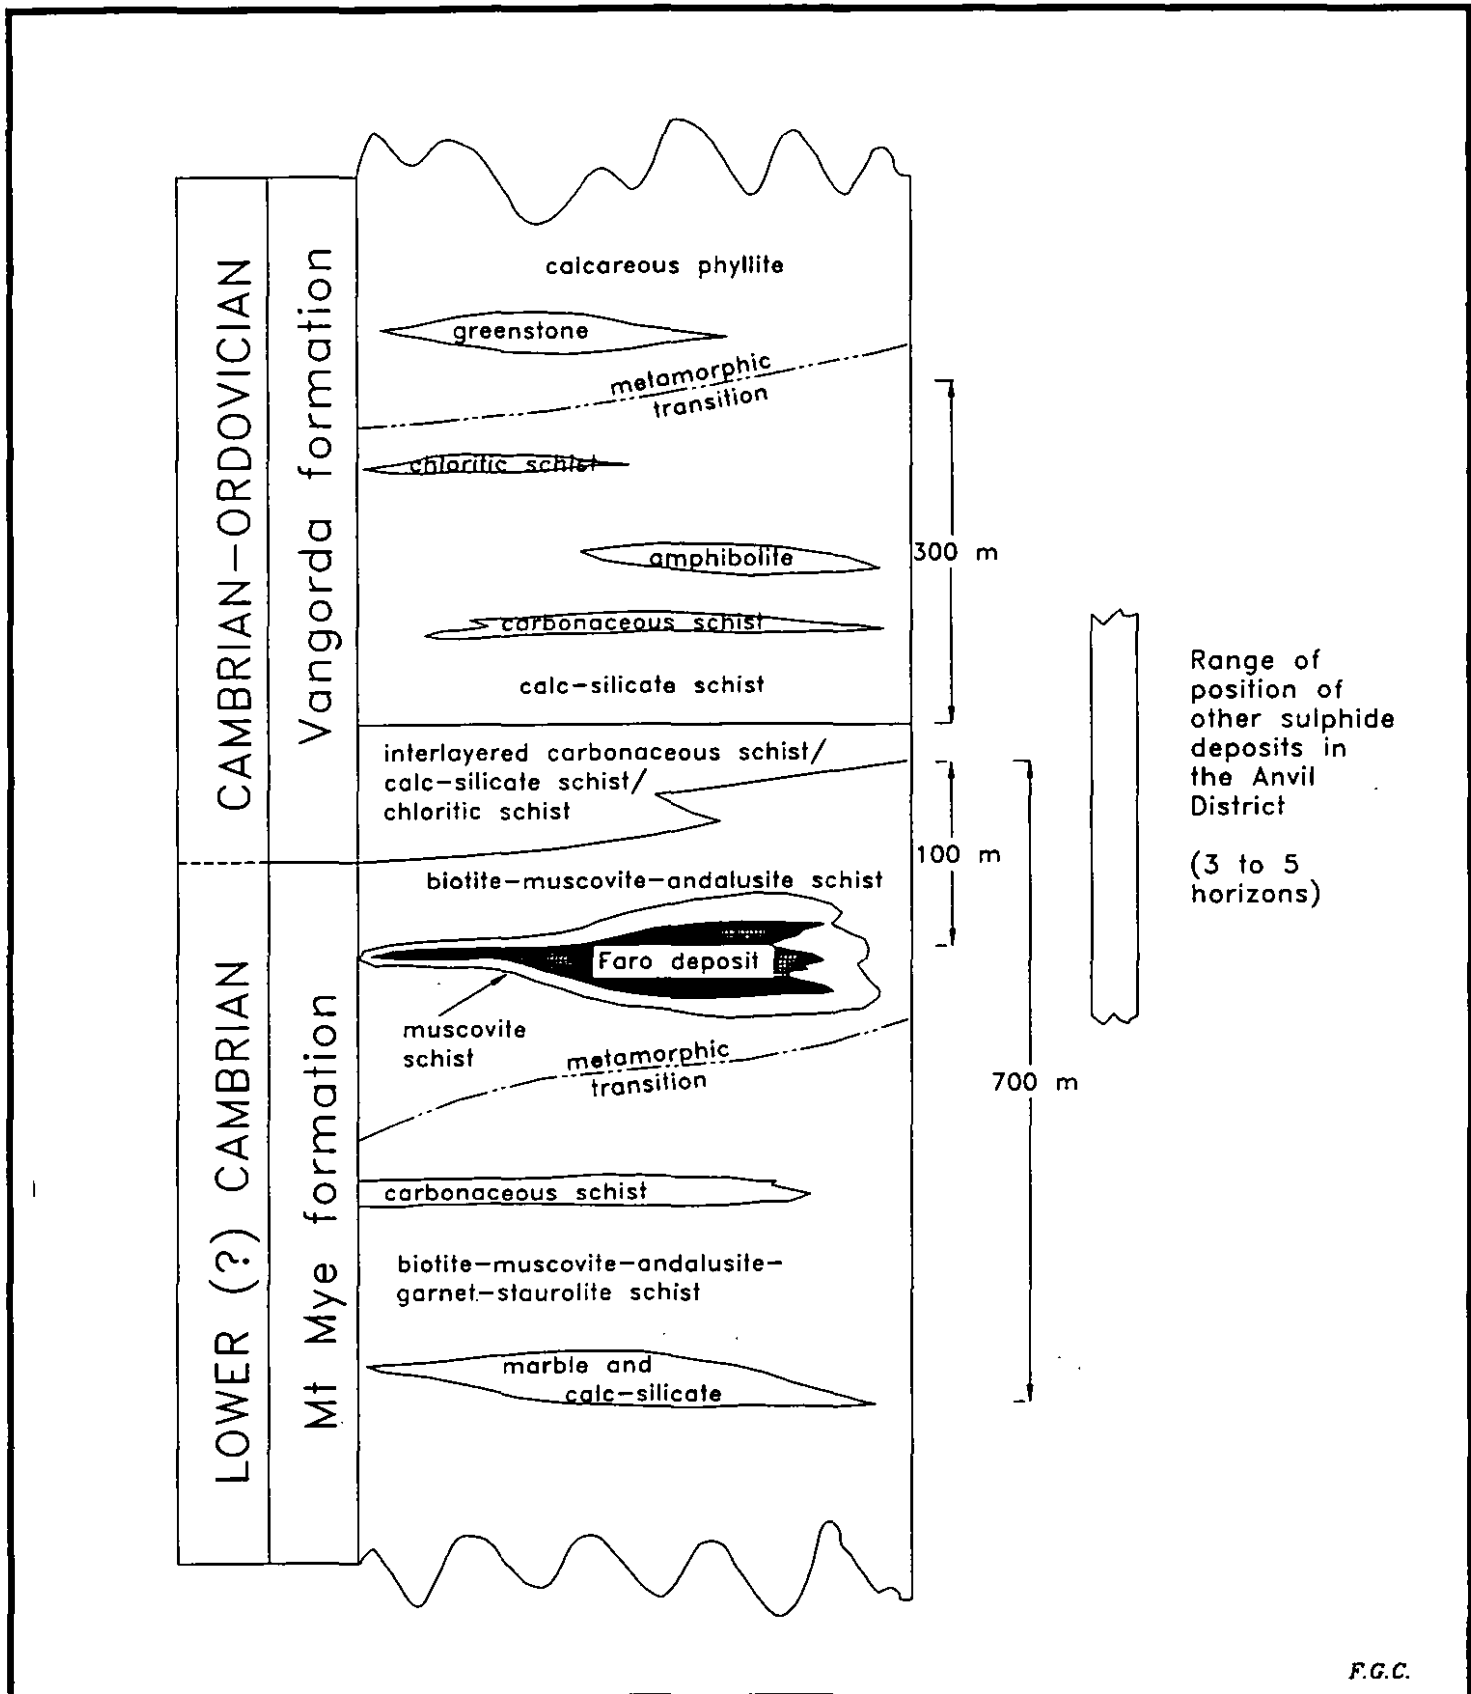

F.G.C.

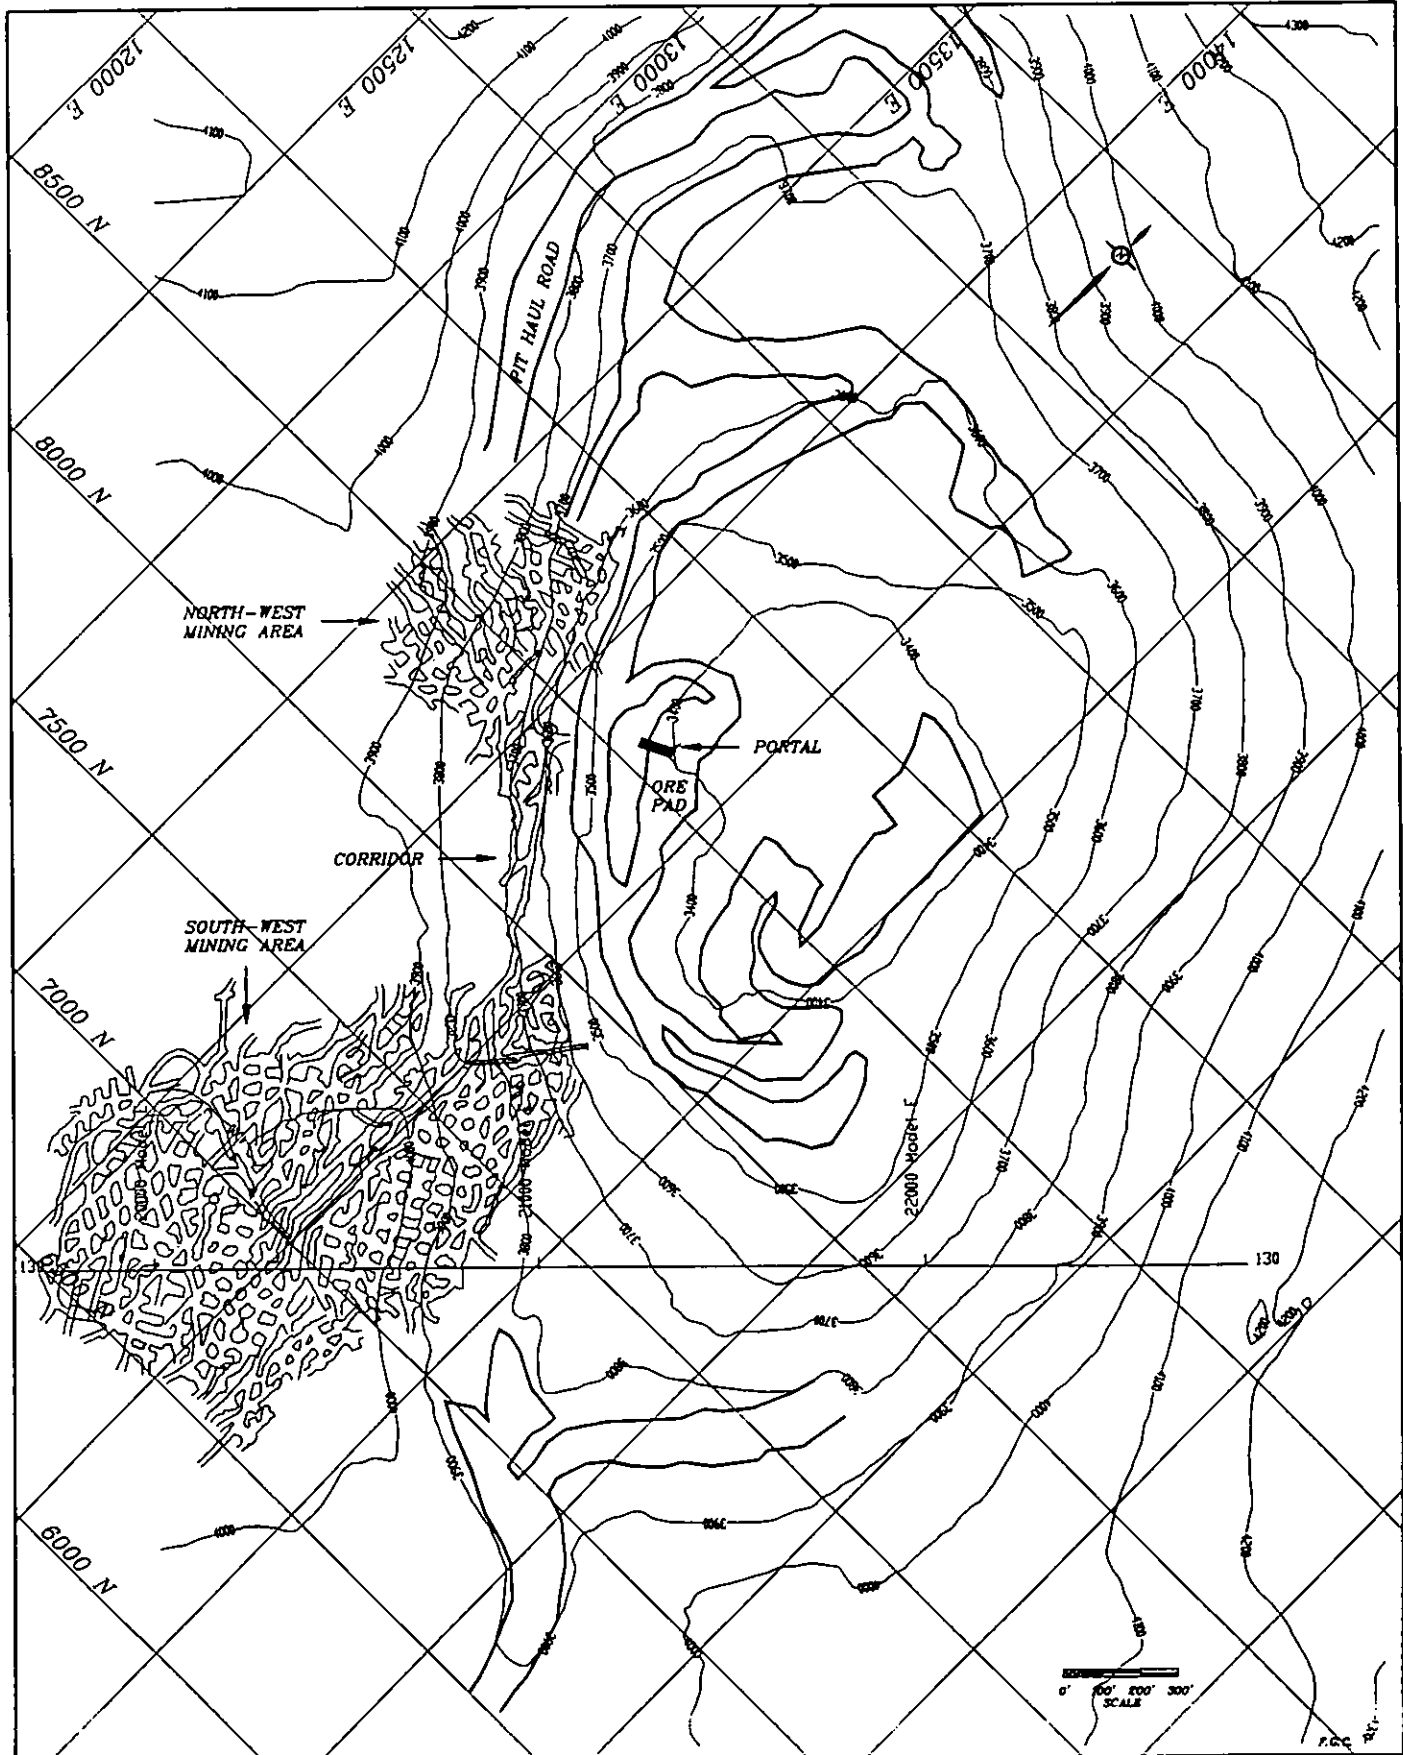


CURRAGH INC.

DESIGNED BY I. BILQUEST, F.G.C. DATE 08/10/90
 DRAWN BY I. BILQUEST, F.G.C. DATE 14/09/92
 FILE FPITCONT AUTOCAD V. 11

SCALE
 1" = 500'


FARO PIT CONTOURS AND
 UNDERGROUND MINE PLAN

PIT-1

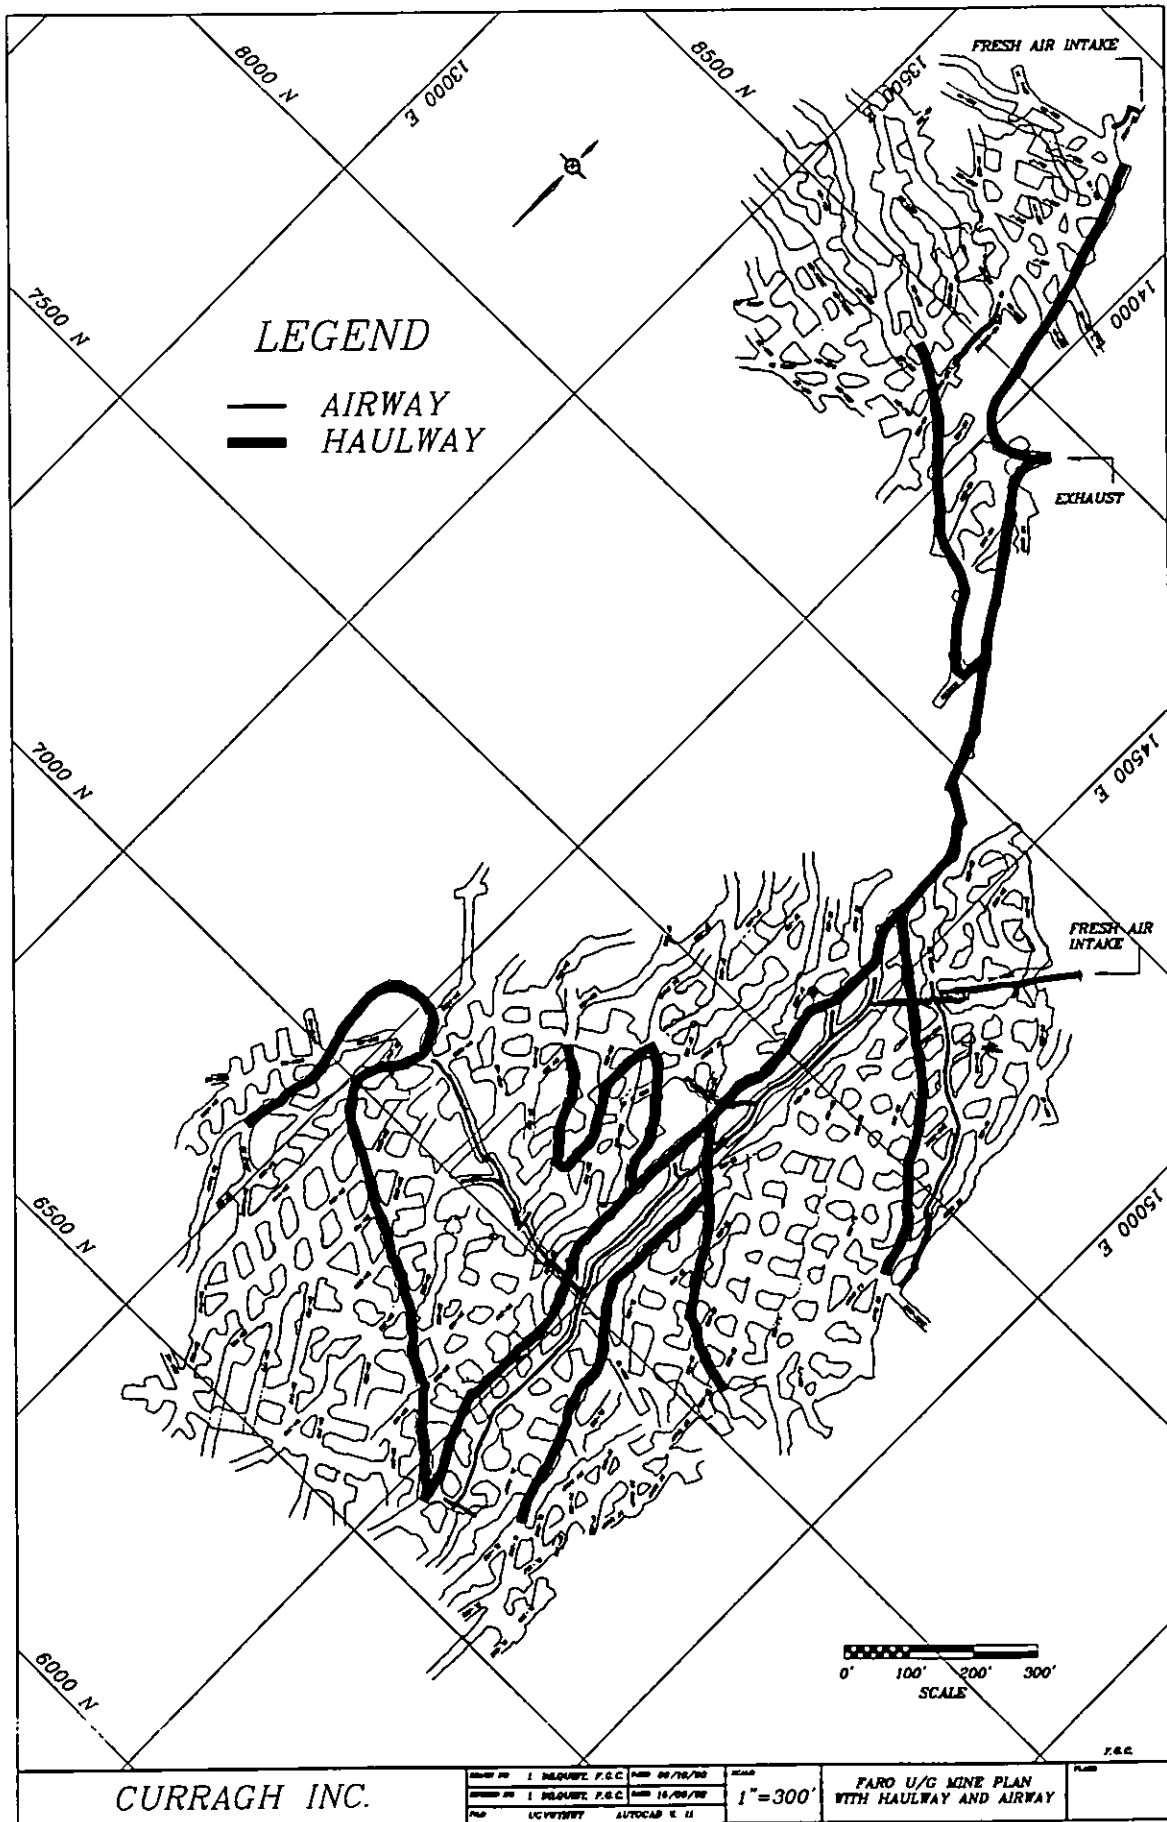

LEGEND

- AIRWAY
- HAULWAY

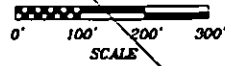


CURRAGH INC.

DESIGN NO	1	REVISION	P.C.C.	DATE	09/16/70	SCALE
DESIGN NO	1	REVISION	P.C.C.	DATE	10/09/70	1"=300'
FILE	LCV70787	AUTOCAD	V. 11			


FARO U/G MINE PLAN WITH HAULWAY AND AIRWAY

P.E.C.

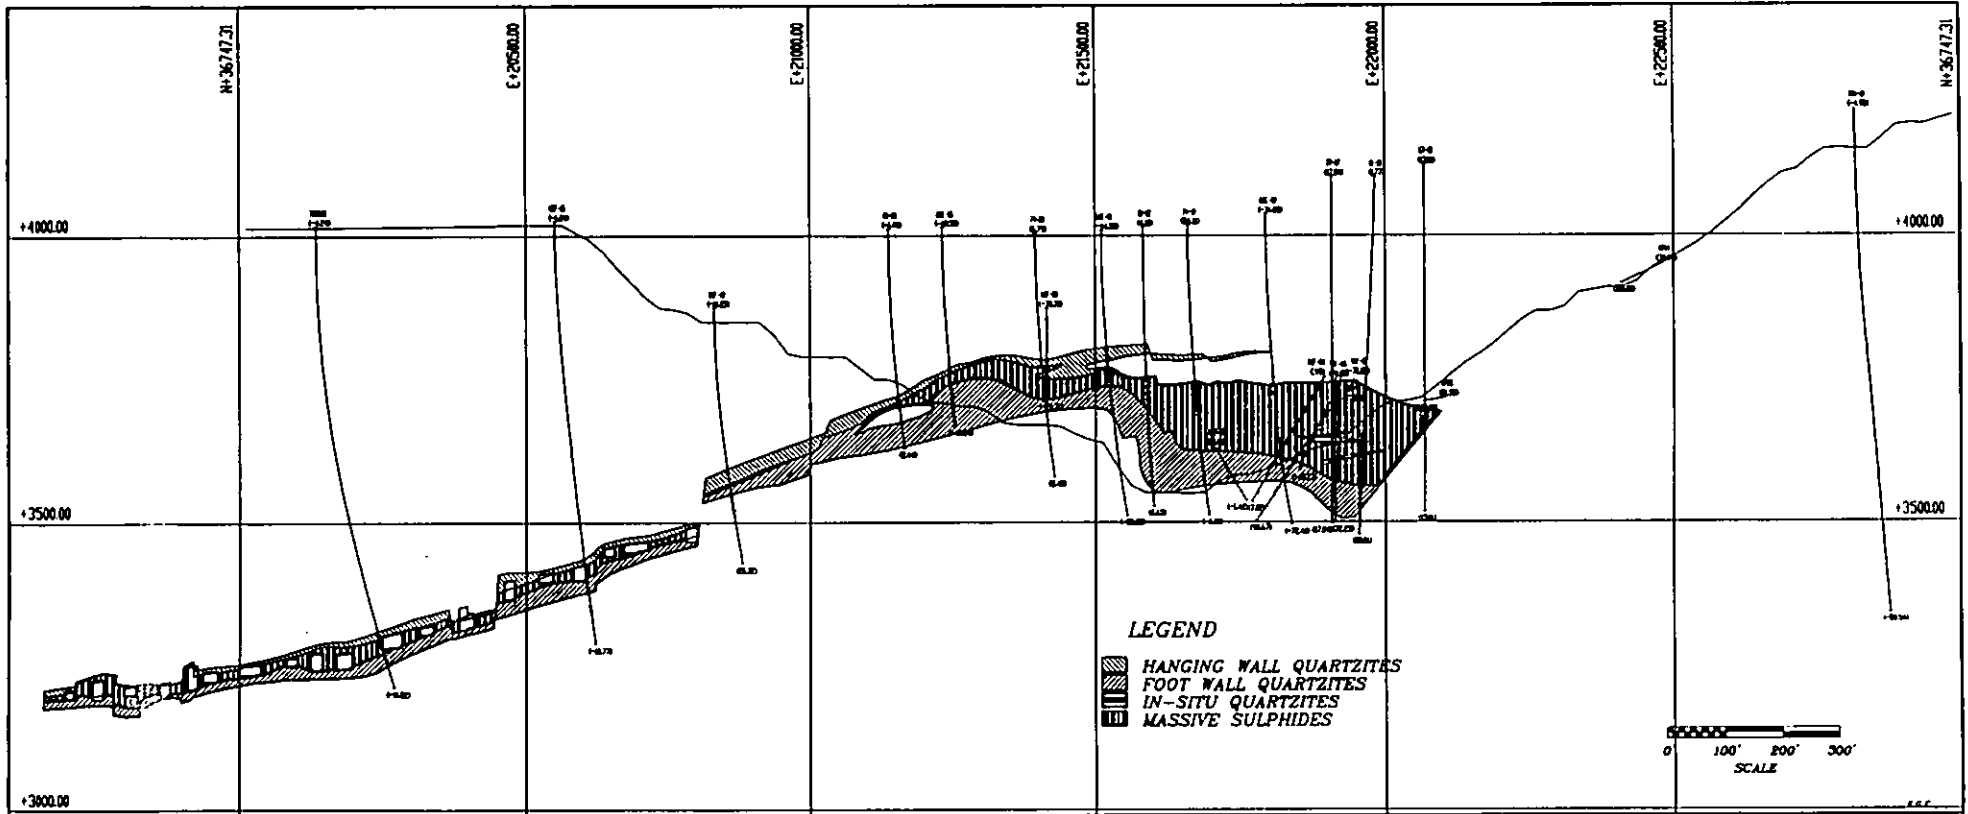

LEGEND


- HANGING WALL QUARTZITES
- FOOT WALL QUARTZITES
- IN-SITU QUARTZITES
- MASSIVE SULPHIDES

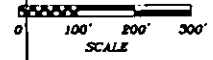

CURRAGH INC.

DESIGNED BY	I. BRIDGEMAN	DATE	12/20/00
DRAWN BY	I. BRIDGEMAN	DATE	12/20/00
CHECKED BY	A. J. HARRIS	DATE	1/11/01
SCALE	AUTOCAD 1:1		


VERTICAL SECTION 130+000
FARO UNDERGROUND AND PIT WORKINGS (LOOKING NW)

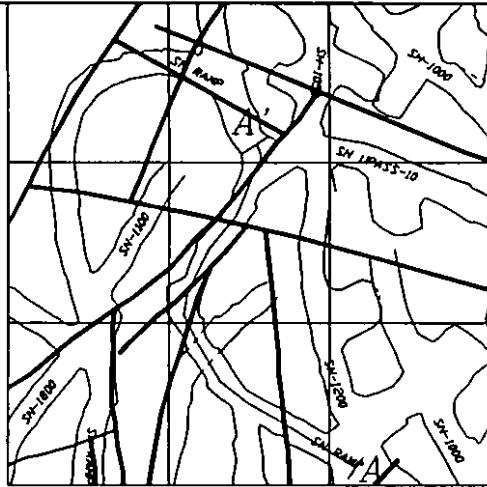



1" = 120'

A'

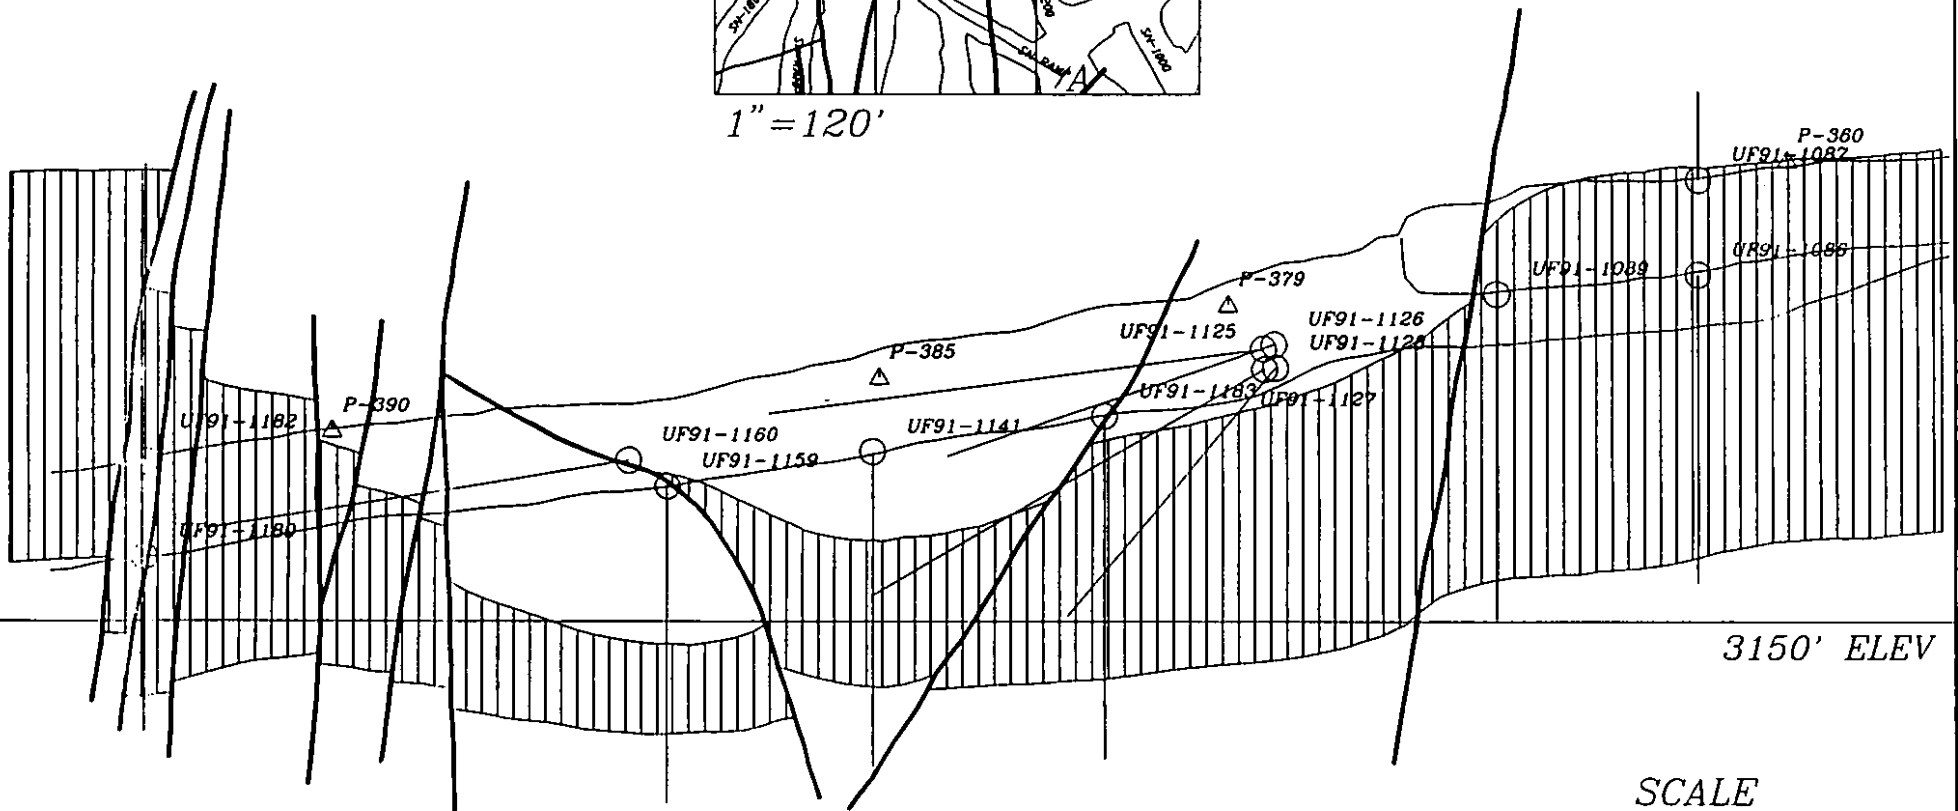A



LEGEND

-  MASSIVE SULPHIDES
-  FAULT

SCALE




F.G.C.

CURRAGH INC.

DRAWN BY: I. BILQUIST, F.G.C. 26/02/92

SCALE: 1" = 30'


SN RAMP PROFILE

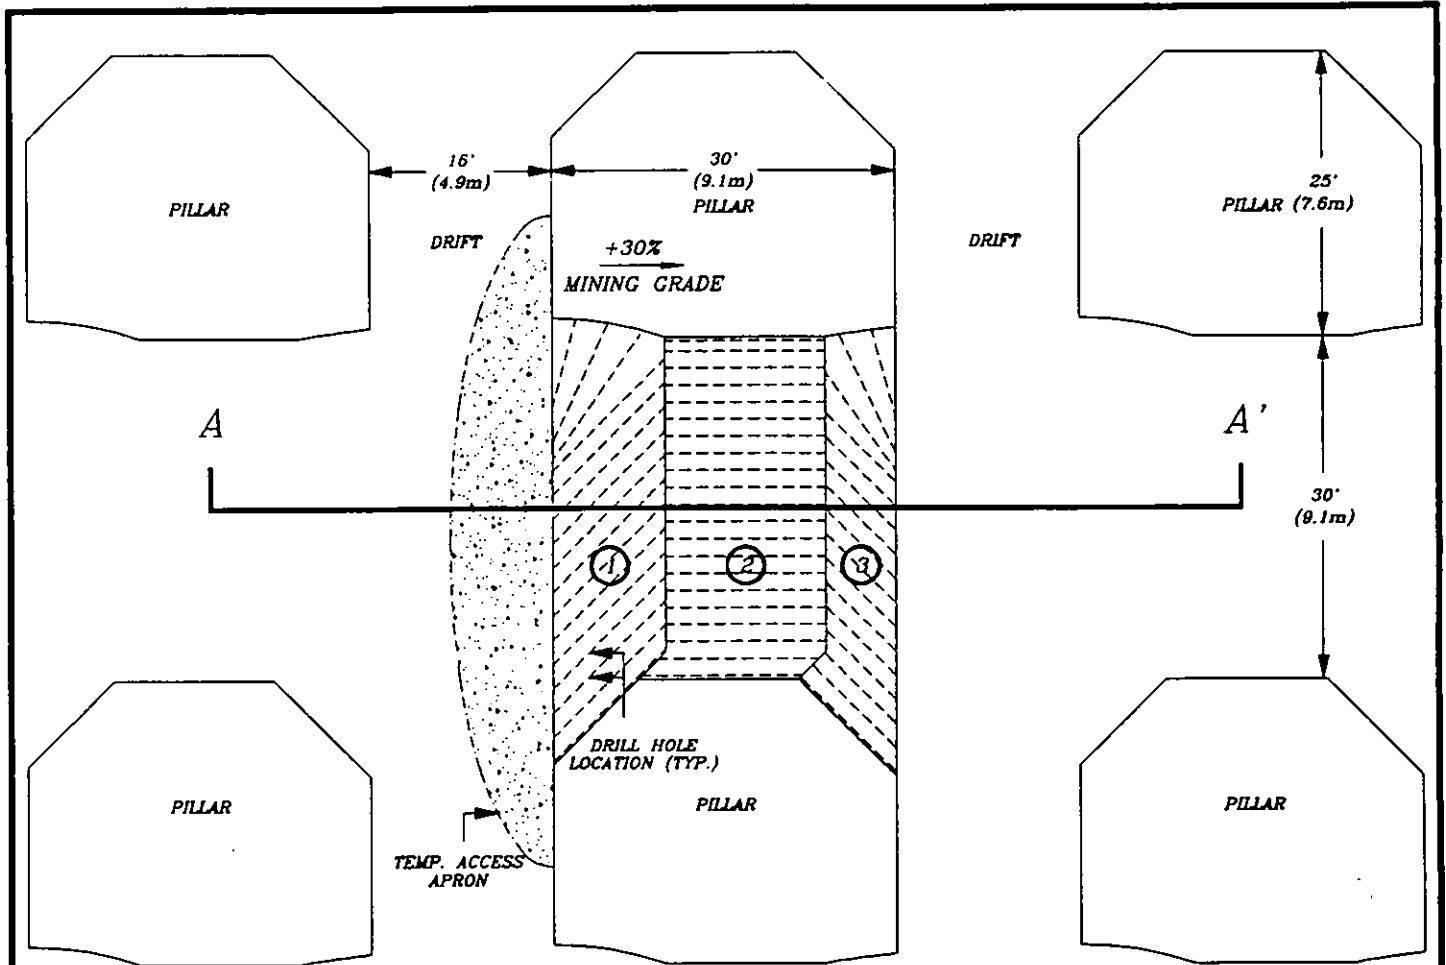

PLAN VIEW

MINING SEQUENCE

- ① 1st SLASH FROM LOWER DRIFT
- ② MINE ROUND FROM LOWER DRIFT
- ③ MINE BREAK-THROUGH SLASH FROM UPPER DRIFT
- ④ TRIM BROW
- ⑤ MINE BENCH FROM LOWER SIDE

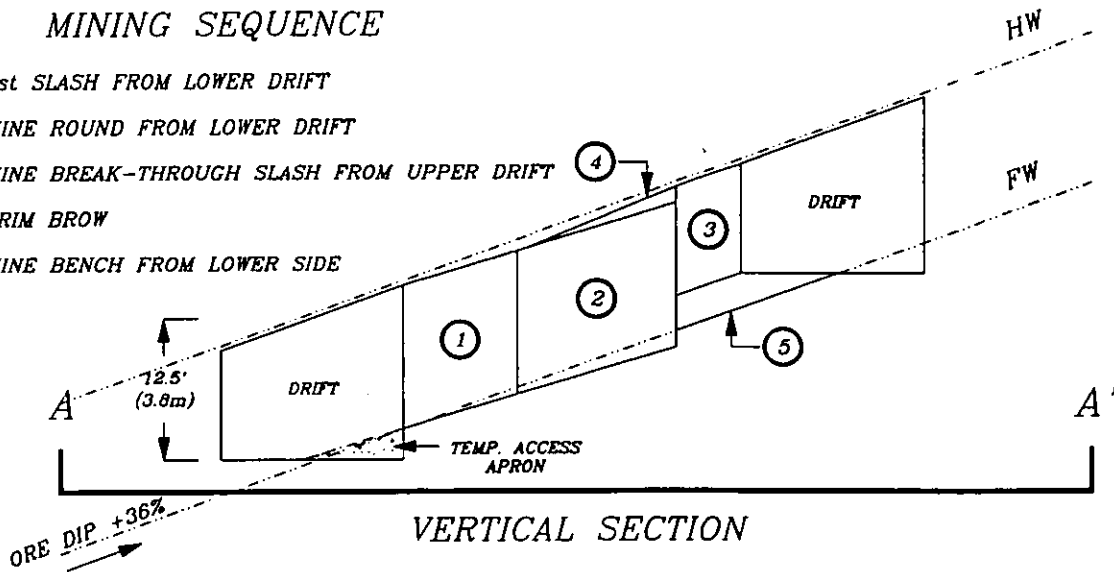

VERTICAL SECTION


F.G.C.

CURRAGH INC.

DRAWN BY:
I. BILQUIST. 17/09/92

FILE:
STOPE AUTOCAD V. 11


TYPICAL SINGLE PASS
30'x30' UP-DIP STOPE

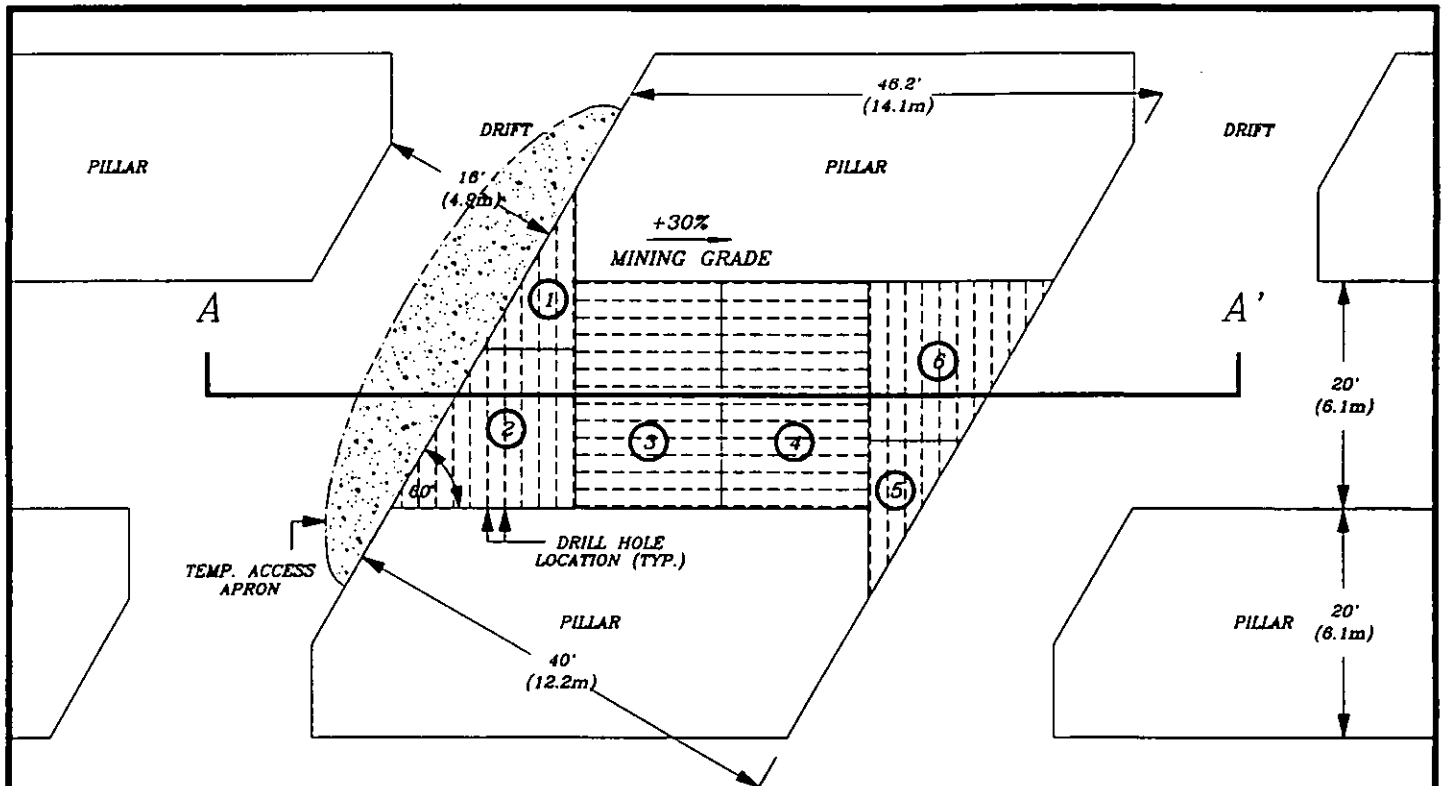

PLAN VIEW

MINING SEQUENCE

- ① 1st SLASH FROM LOWER DRIFT
- ② 2nd SLASH FROM LOWER DRIFT (TO SQUARE FACE)
- ③ 1st ROUND FROM LOWER DRIFT
- ④ 2nd ROUND FROM LOWER DRIFT
- ⑤ 1st BREAK-THROUGH SLASH FROM UPPER DRIFT
- ⑥ 2nd BREAK-THROUGH SLASH FROM UPPER DRIFT
- ⑦ MINE BENCH FROM LOWER SIDE

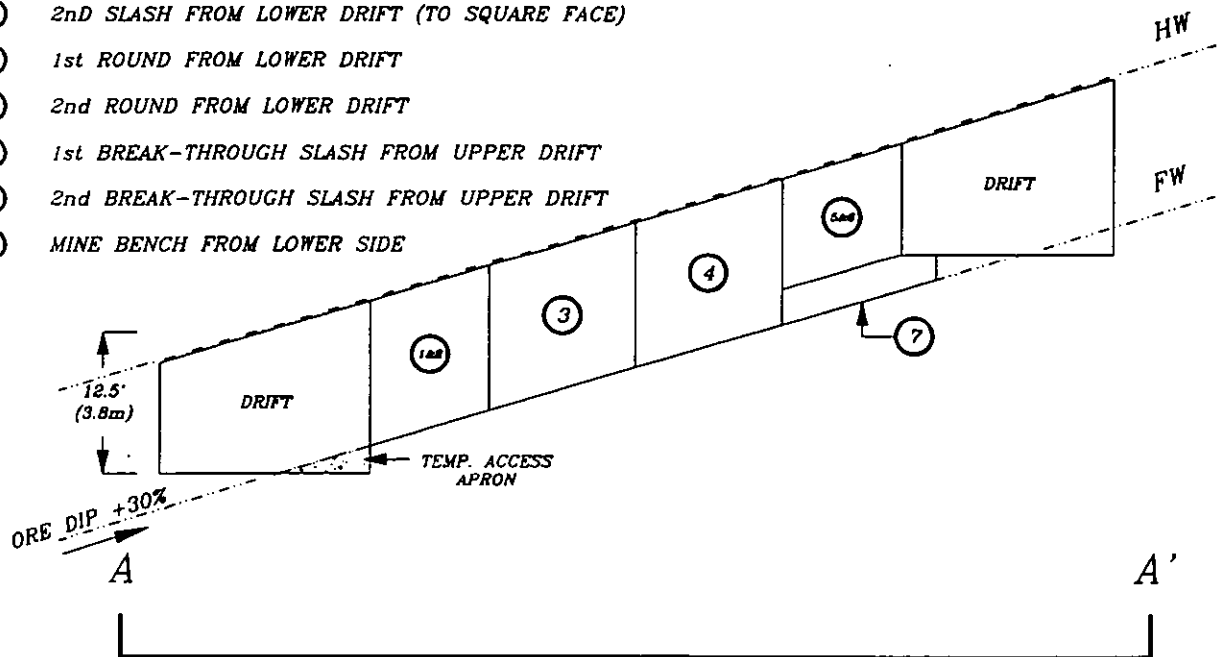

VERTICAL SECTION

F.G.C.

CURRAGH INC.

DRAWN BY:
I. BILQUIST, 17/09/92
FILE:
STOPE AUTOCAD V. 11

**TYPICAL SINGLE PASS
20' WIDE X-PITCH STOPE**

Table 1

The major pieces of equipment list as follows:

- 1 - Three boom electric hydraulic jumbo
- 1 - Two boom electric hydraulic jumbo
- 1 - Loading jumbo
- 1 - Intermediate loader
- 2 - 8 cu. yd. scooptram
- 1 - 5 cu. yd. scooptram
- 1 - 2.5 cu. yd. scooptram
- 3 - 26 cu. yd. trucks
- 1 - Rockbolt jumbo
- 2 - Tractor type service vehicles
- 1 - D-3 dozer
- 1 - Boom truck
- 2 - 600 cfm compressor