


002612

3910-
Elected Dec 23/75
Cut 45' + 5'
~~21,000 Tons~~
~~2.6 % Pb~~
~~4.1 % Zn~~

Dev. Ore for Jan, 1976.

* X-Ray Assays Only - Primary Phase

- ≥ 9% Pb+Zn
- ≥ 5% Pb+Zn
- ≥ 3% Pb+Zn
- < 3% Pb+Zn

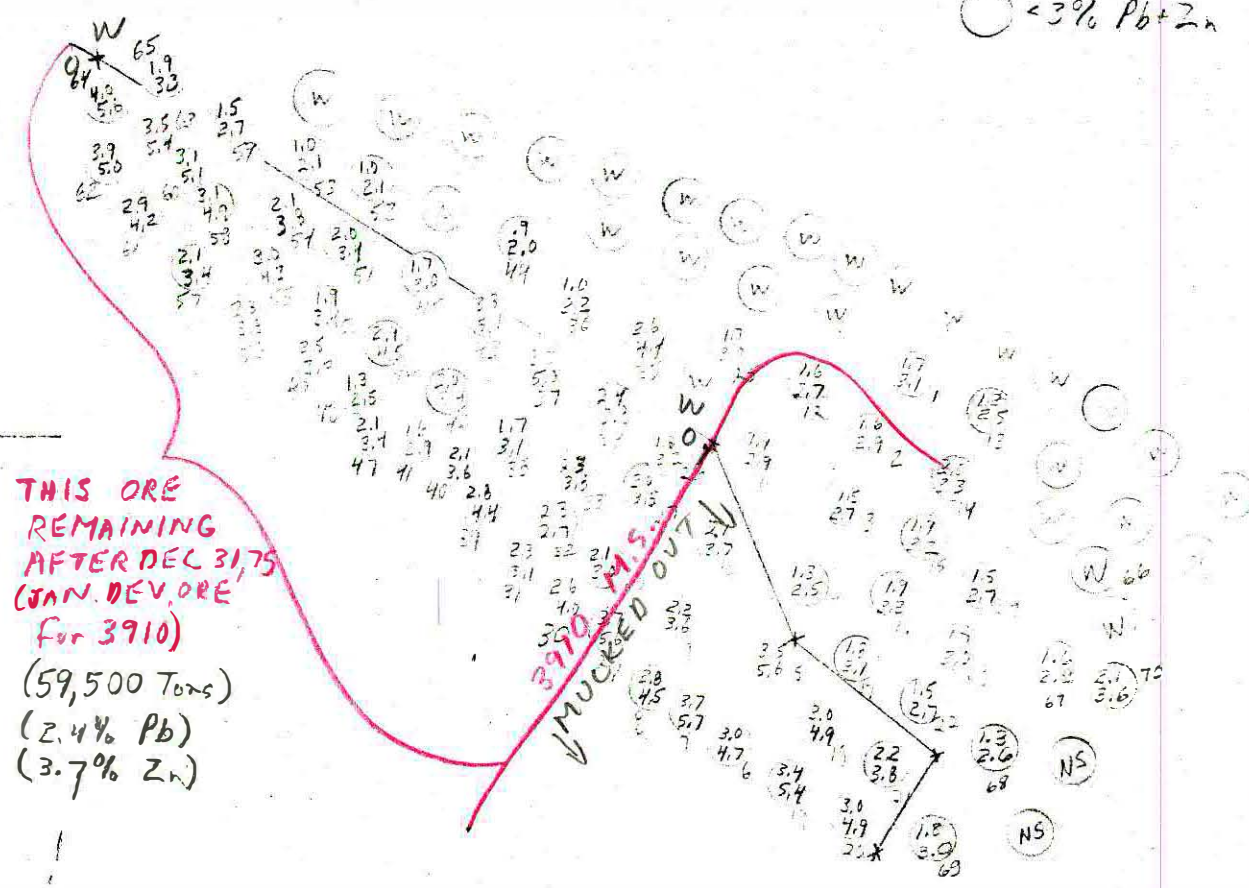

THIS ORE
REMAINING
AFTER DEC 31, 75
(JAN. DEV. ORE
FOR 3910)
(59,500 Tons)
(2.4% Pb)
(3.7% Zn)

C.C.
JCD
DGB
LPT
MOH
FILE

1" = 50'