
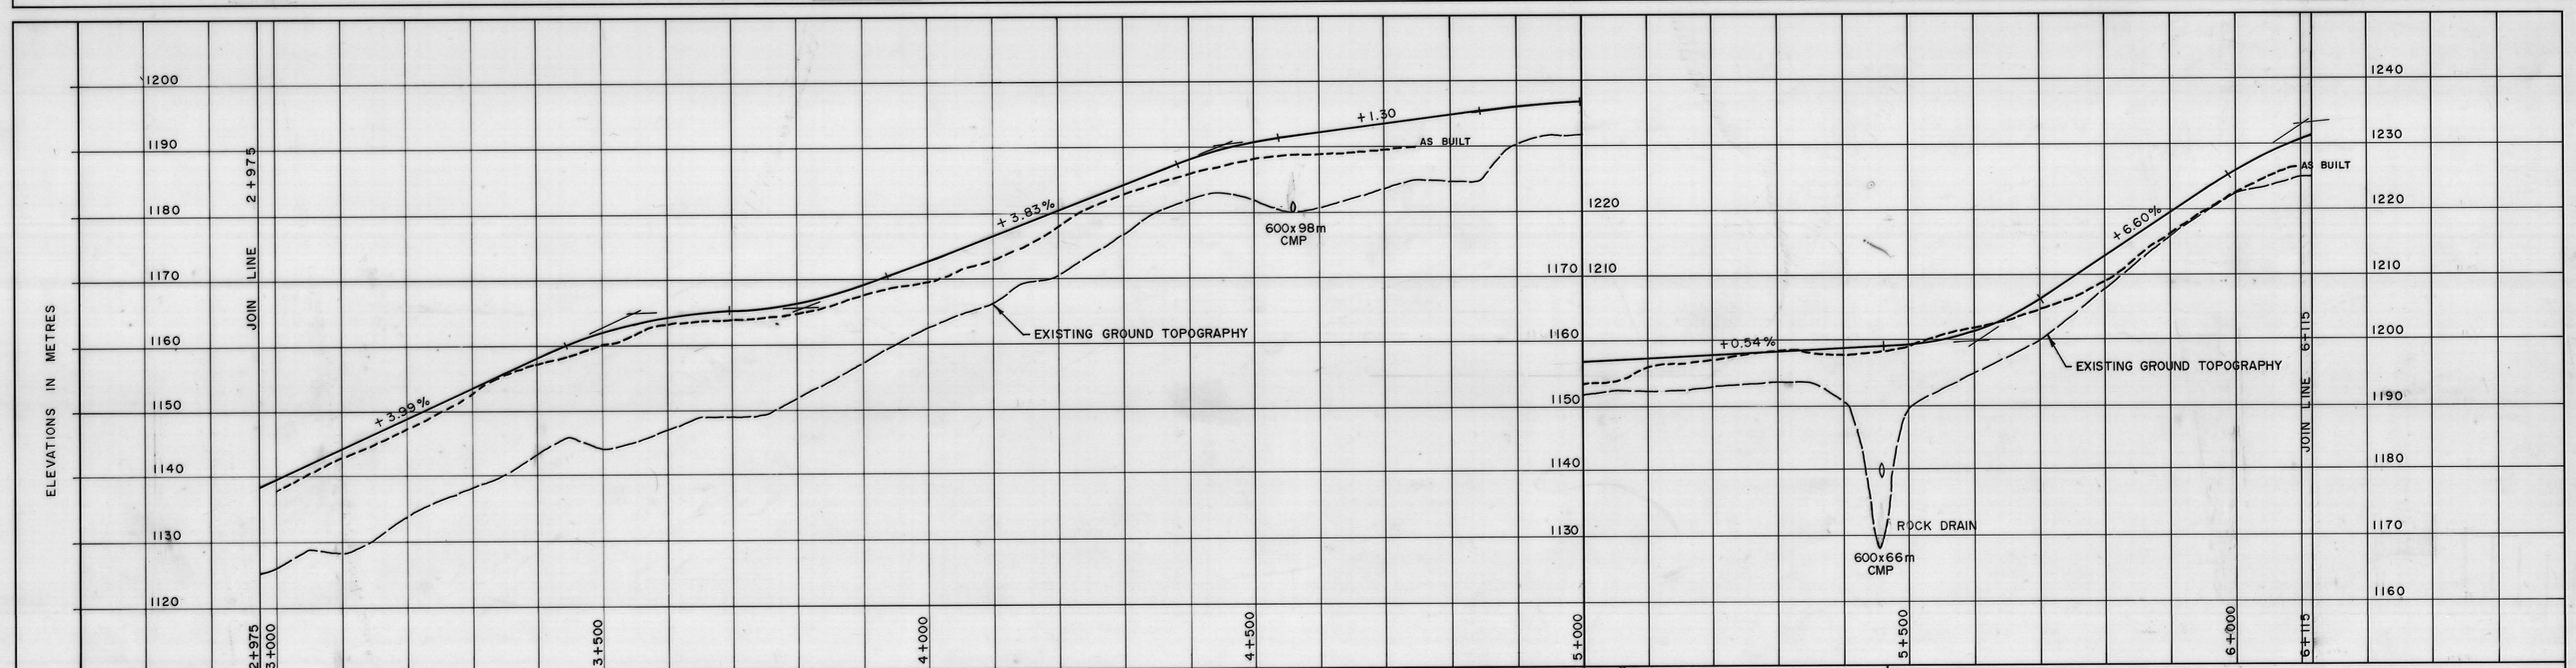


AN-VP-90-008  
 Vangorda Plateau Haul Road  
 Plan & Profile  
 As Built  
 Fig 2.19

007803

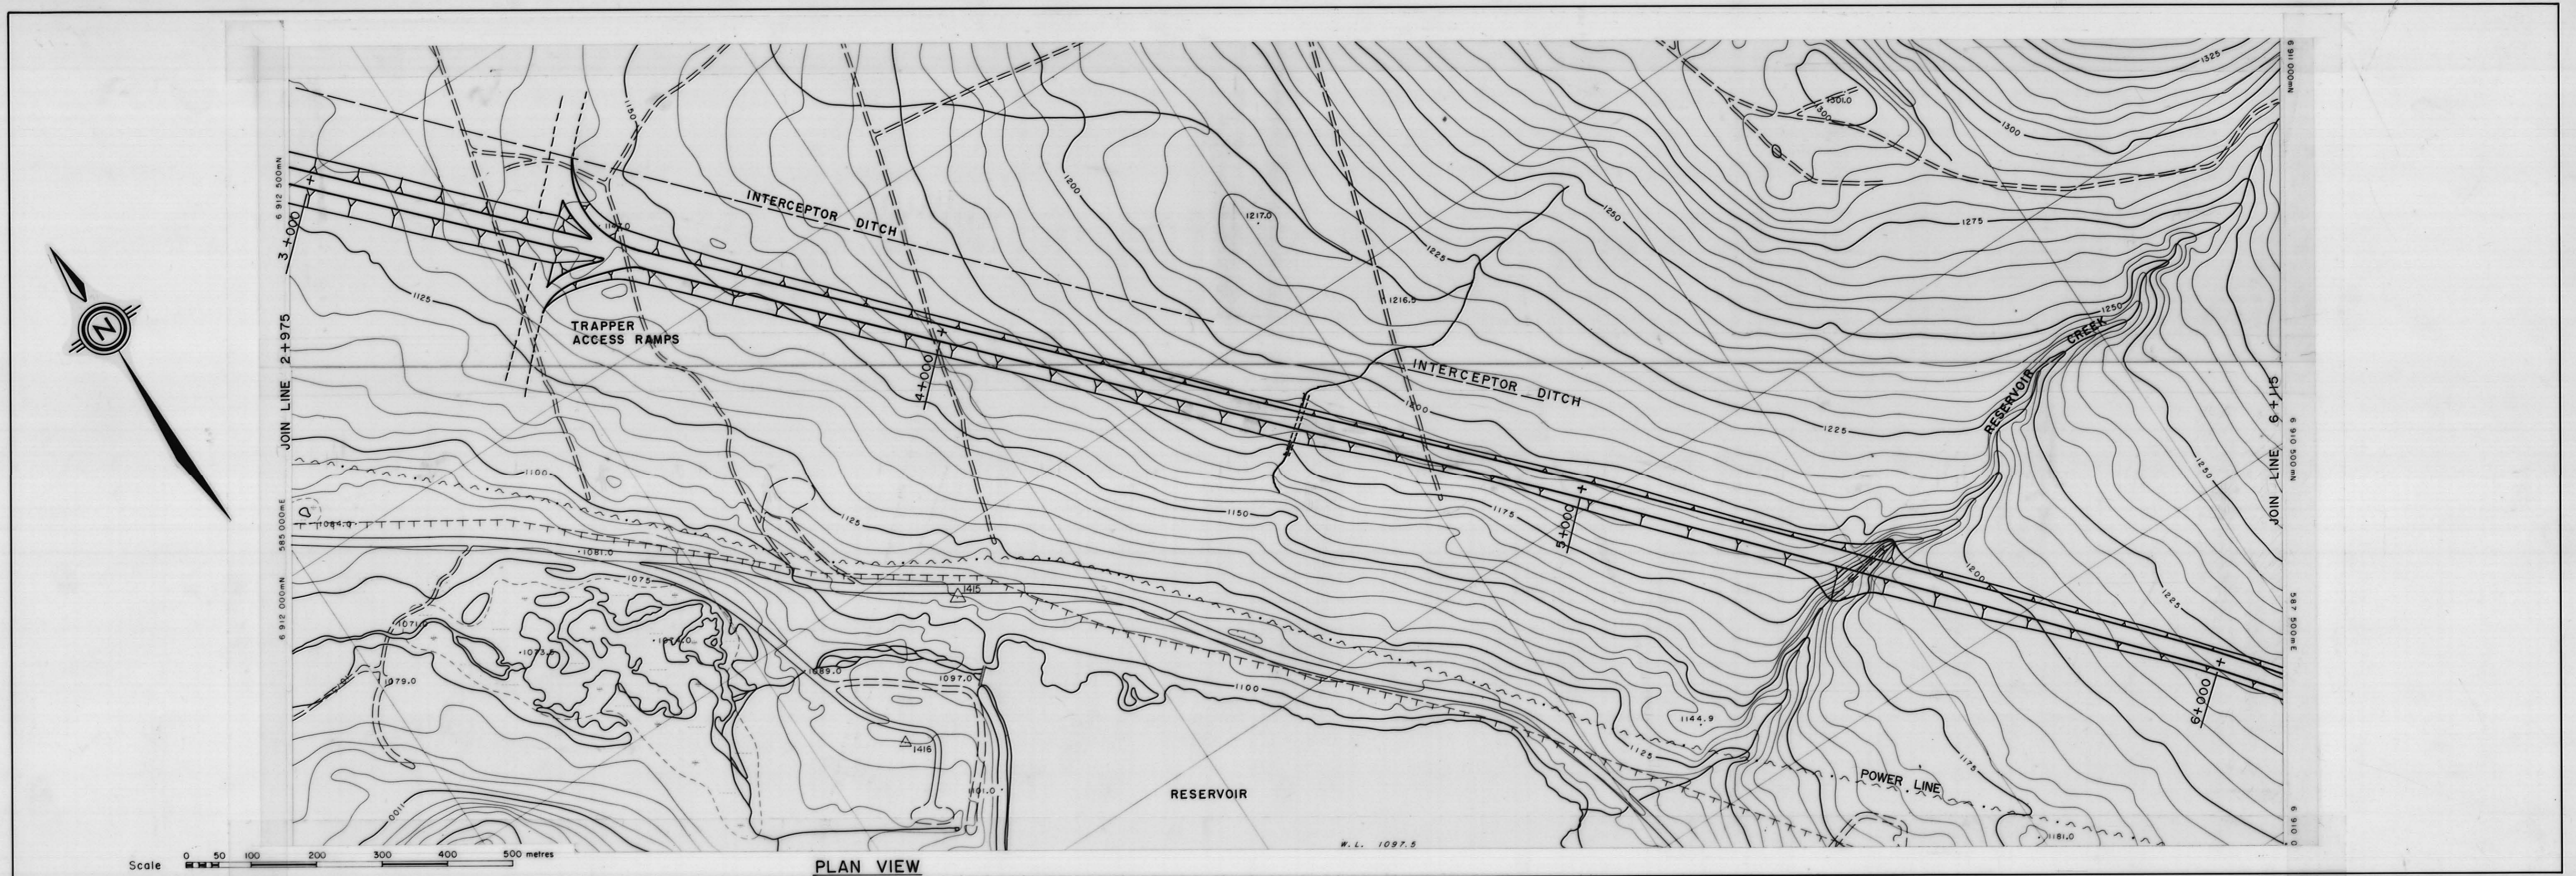

ROAD PROFILE ALONG CENTRE-LINE IN METRES

REVISED: 90/12/12

Vertical Exaggeration X 10

HORIZONTAL SCALE  
 0 50 100 200 300 400 500 metres

VERTICAL SCALE  
 0 5 10 20 30 40 50 metres

**Caragh Resources Inc.**

VANGORDA PLATEAU HAUL ROAD  
 PLAN & PROFILE

STATION 2+975 to STATION 6+115

FIGURE 2.19

