
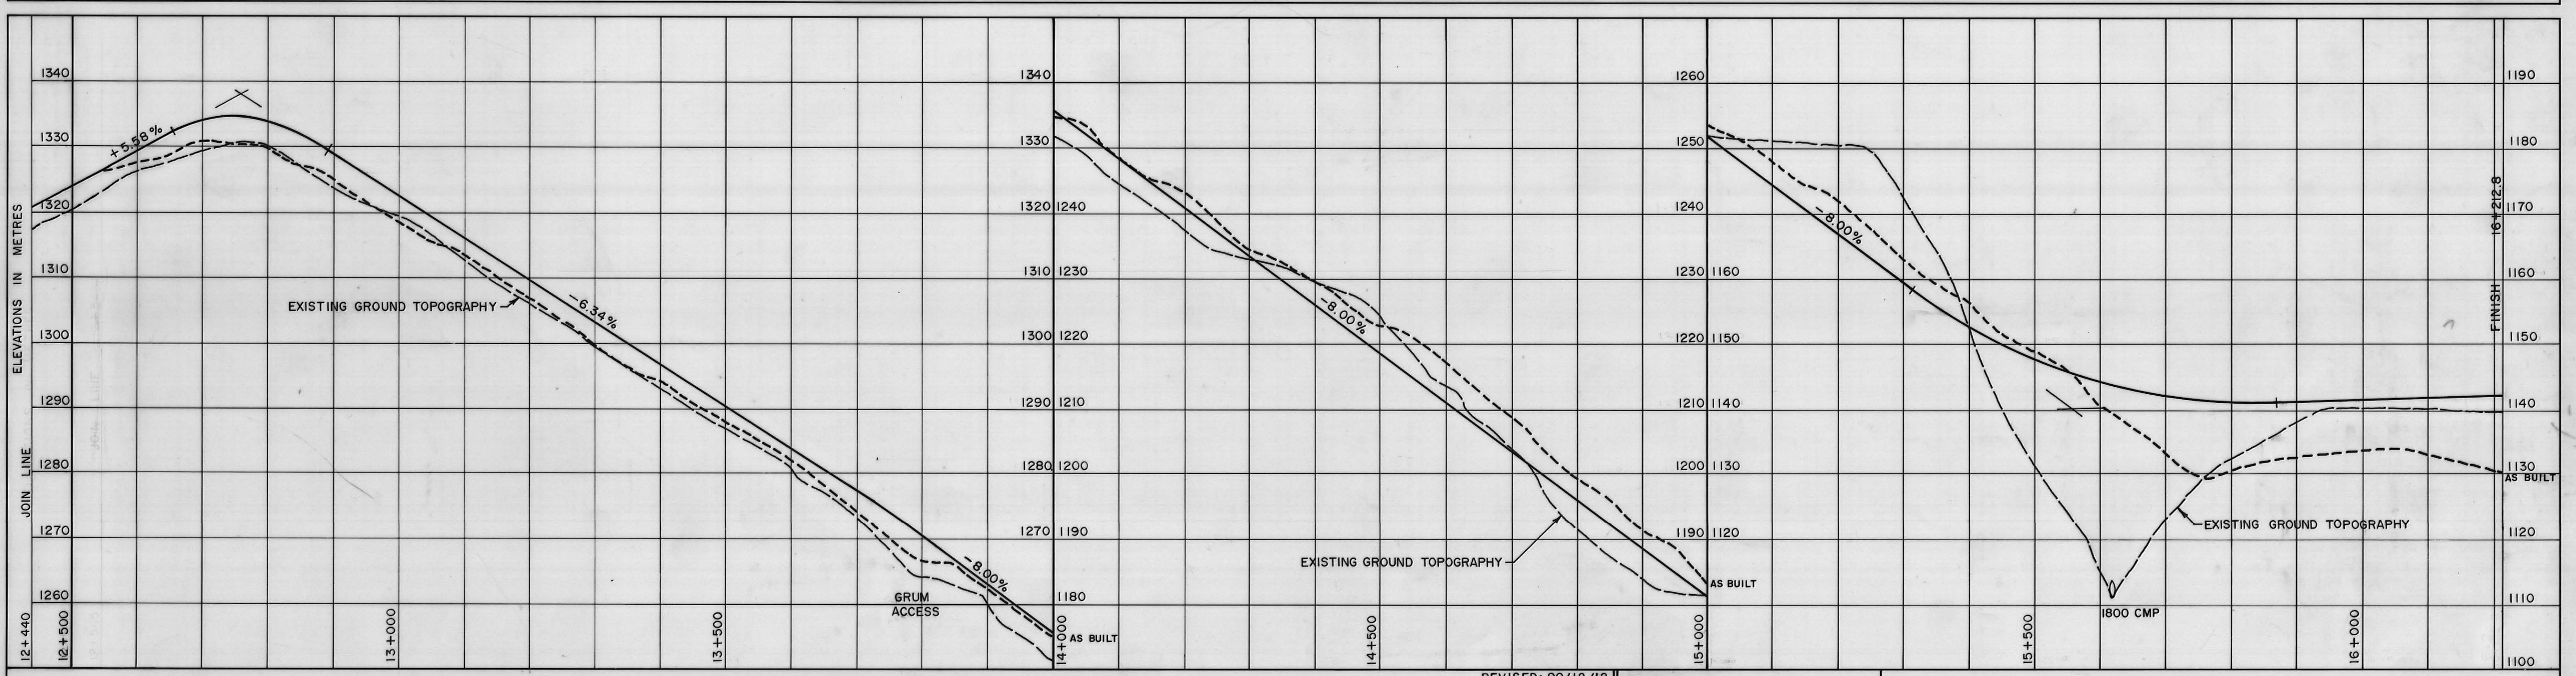


AN-VP-90-011  
 Vangorda Plateau Haul Road  
 Plan & Profile  
 AS Built

007806

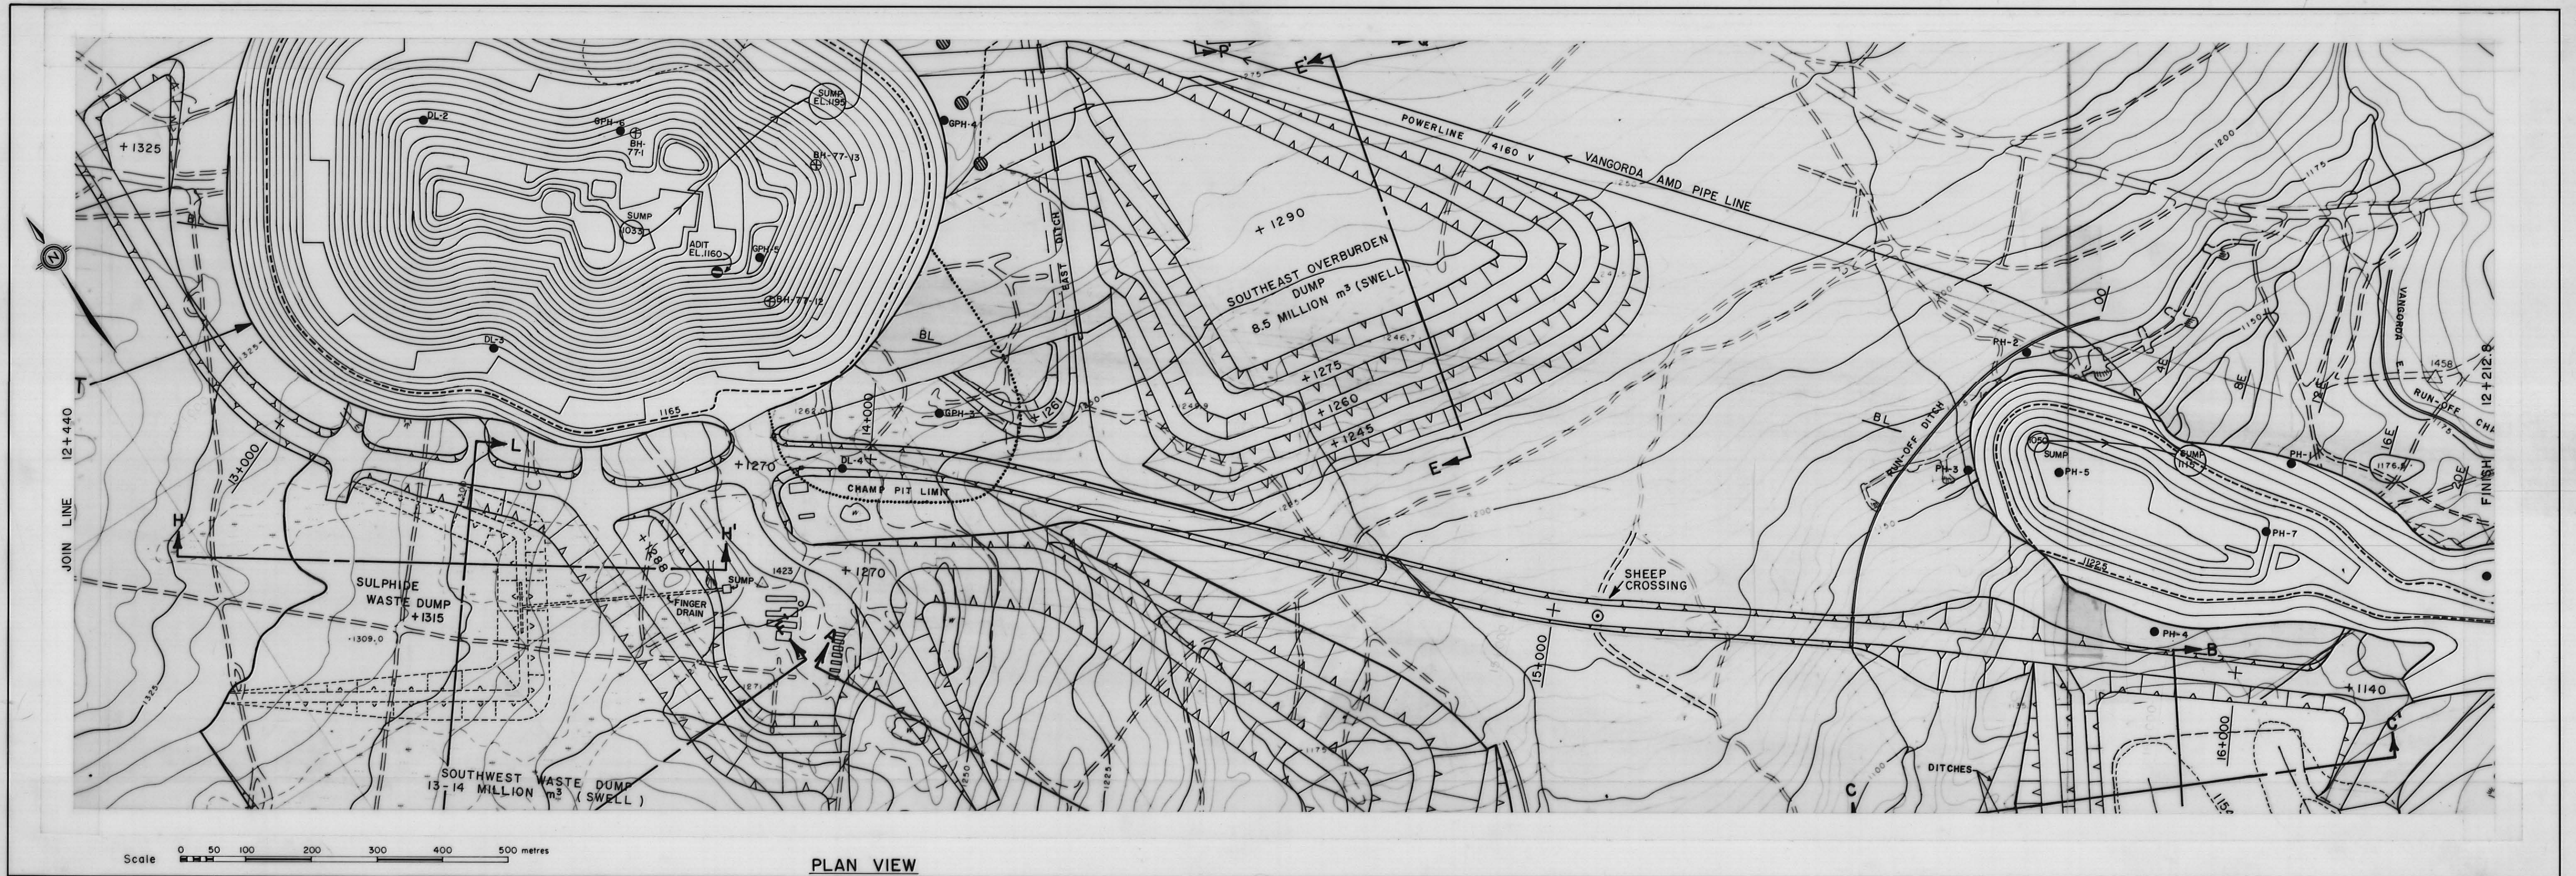

Vertical Exaggeration X 10

HORIZONTAL SCALE: 0 50 100 200 300 400 500 metres

VERTICAL SCALE: 0 5 10 20 30 40 50 metres

REVISED: 90/12/12

AN-VP-90-011

**Carraig Resources Inc.**

**VANGORDA PLATEAU HAUL ROAD  
 PLAN & PROFILE**

STATION 12+440 to STATION 16+212.8

FIGURE 2.22

