



AN-VP-90-010
 Vangorda Plateau Haul Road
 Plan & Profile
 As Built
 Fig 2.21

007807

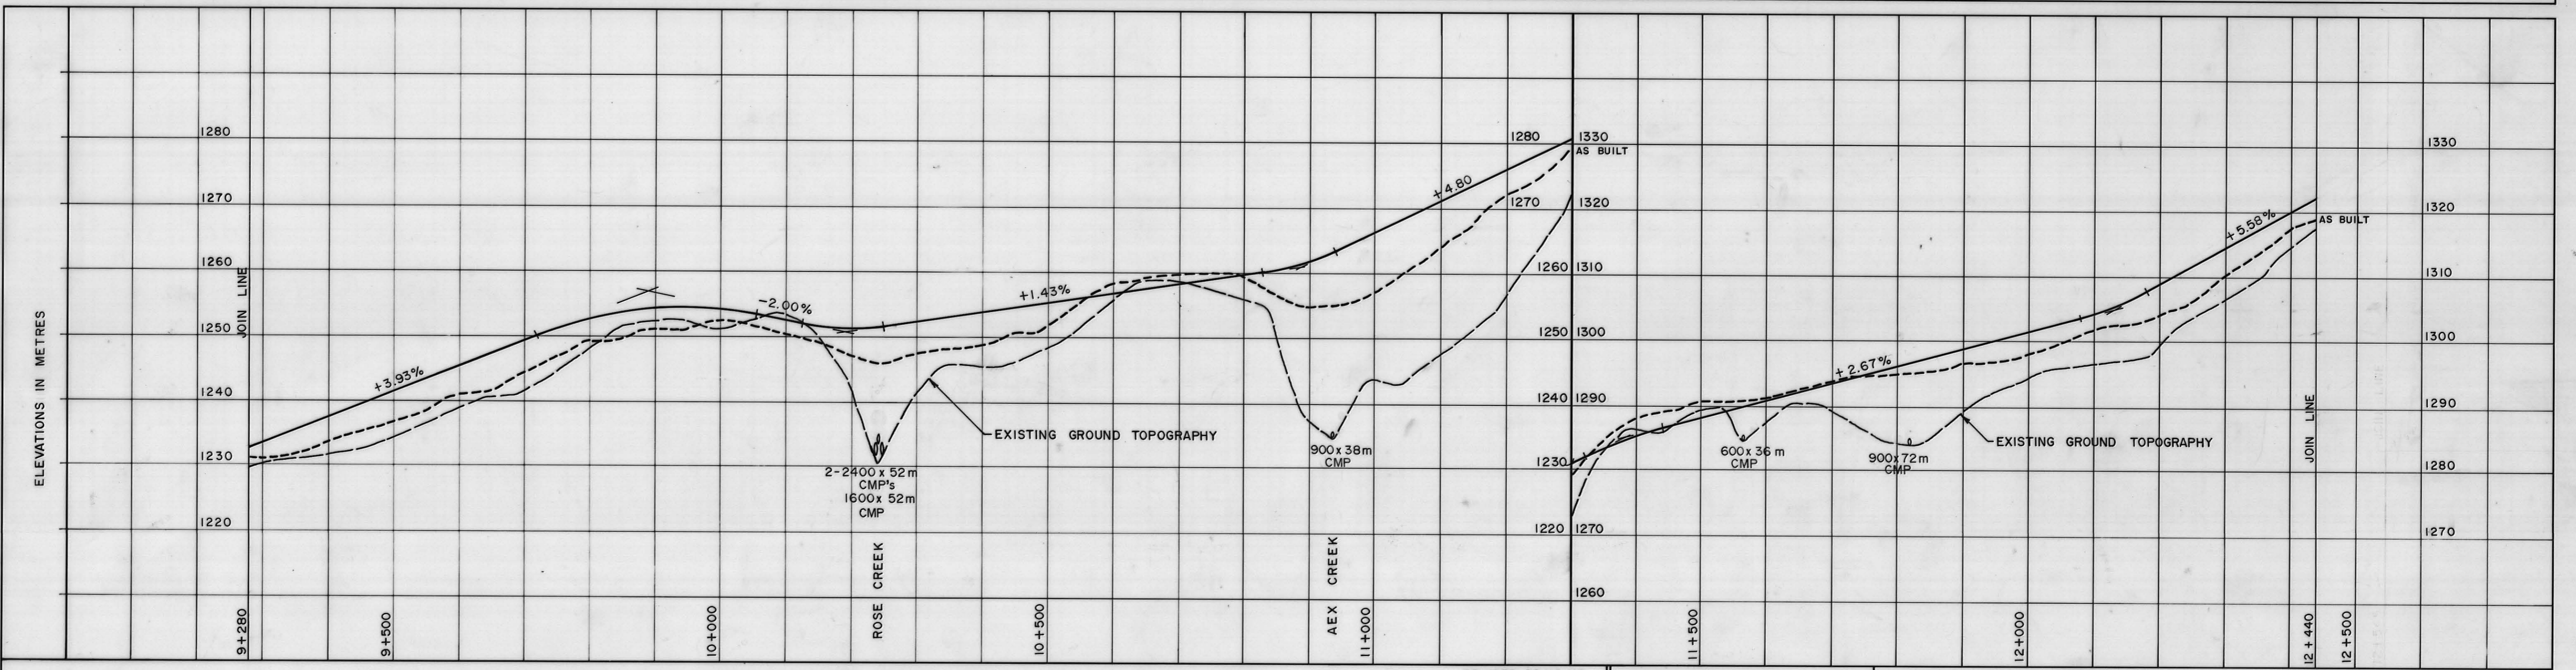

Vertical Exaggeration X 10
 HORIZONTAL SCALE 0 50 100 200 300 400 500 metres
 VERTICAL SCALE 0 5 10 20 30 40 50 metres
 ROAD PROFILE ALONG CENTRE-LINE IN METRES
 REVISED: 90/12/12
 AN-VP-90-010

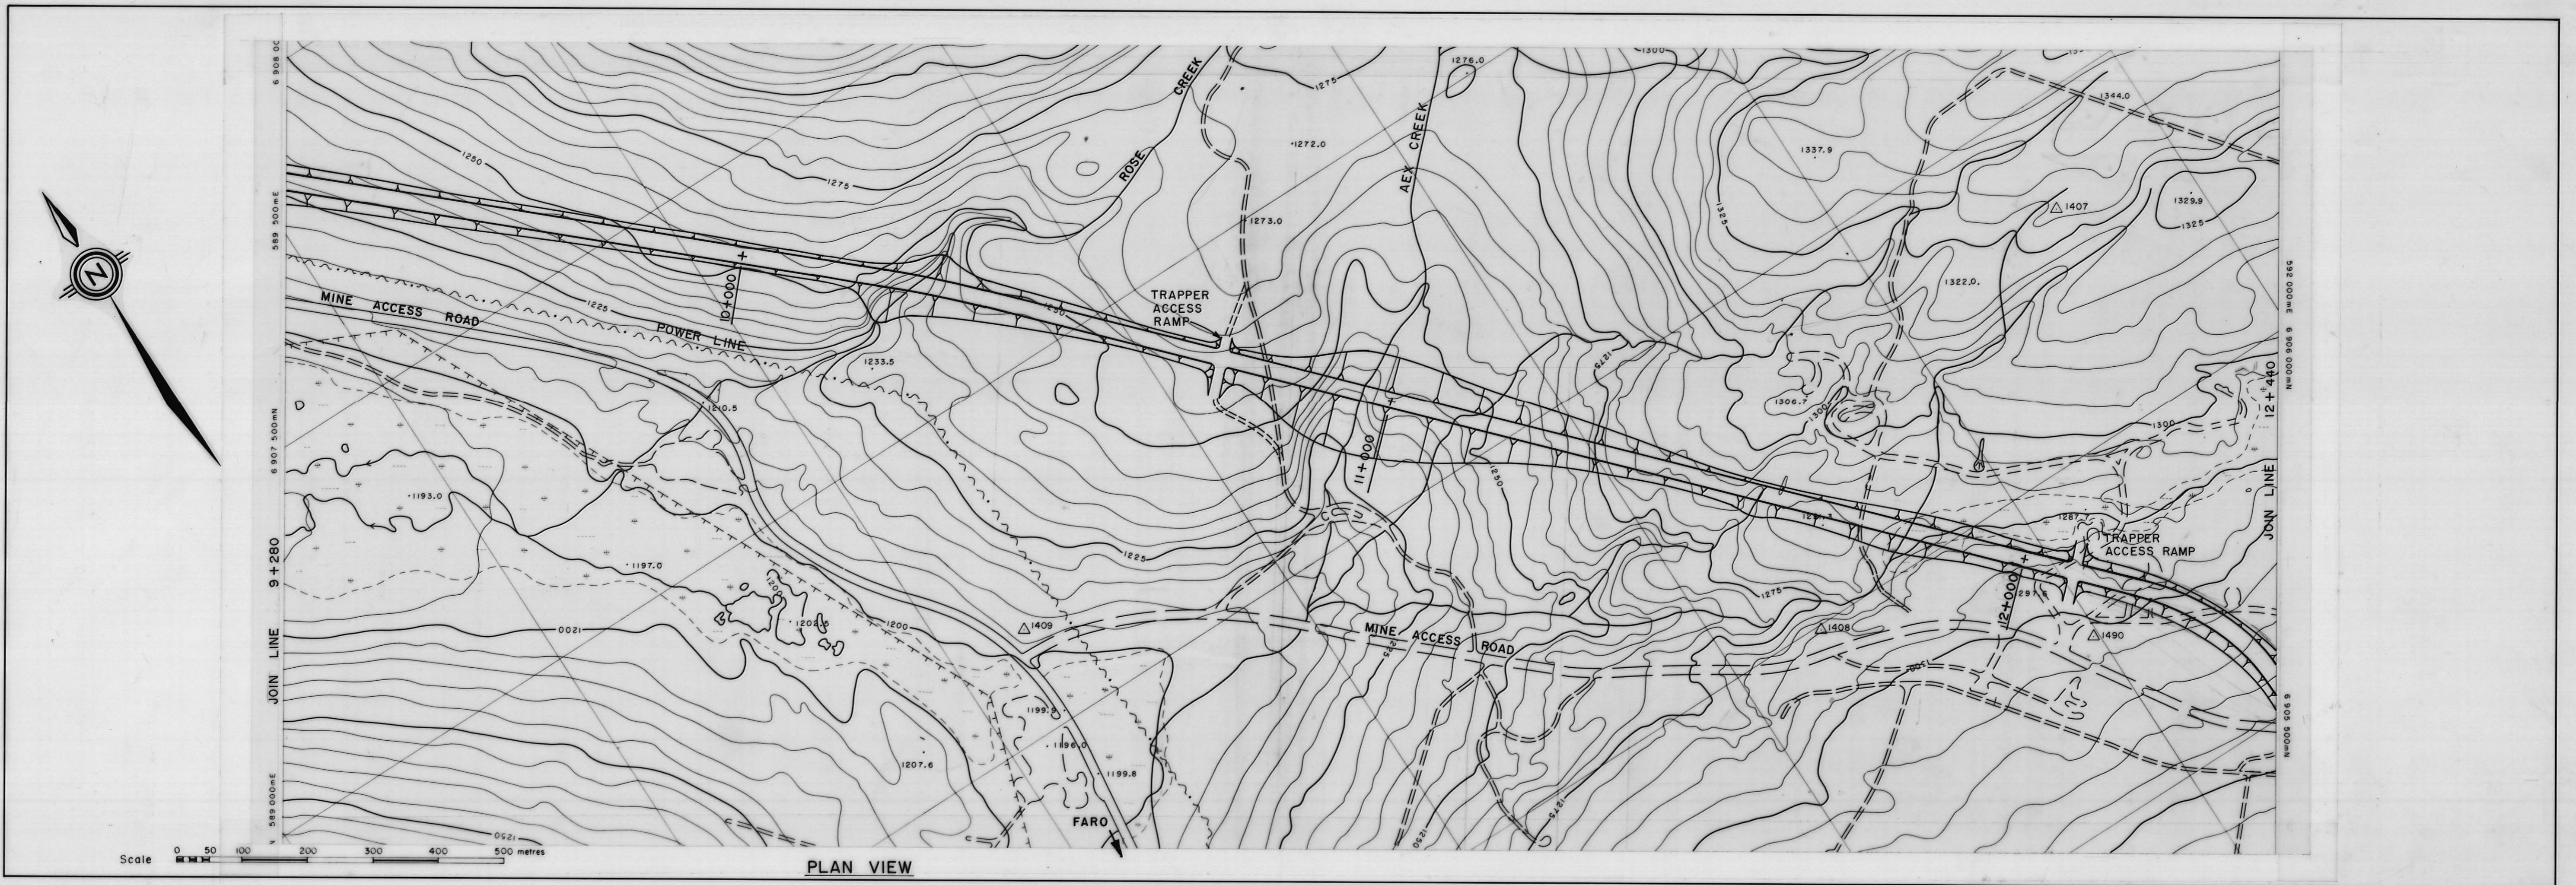

VANGORDA PLATEAU HAUL ROAD
 PLAN & PROFILE
 STATION 9+280 to STATION 12+440
 FIGURE 2.21

