
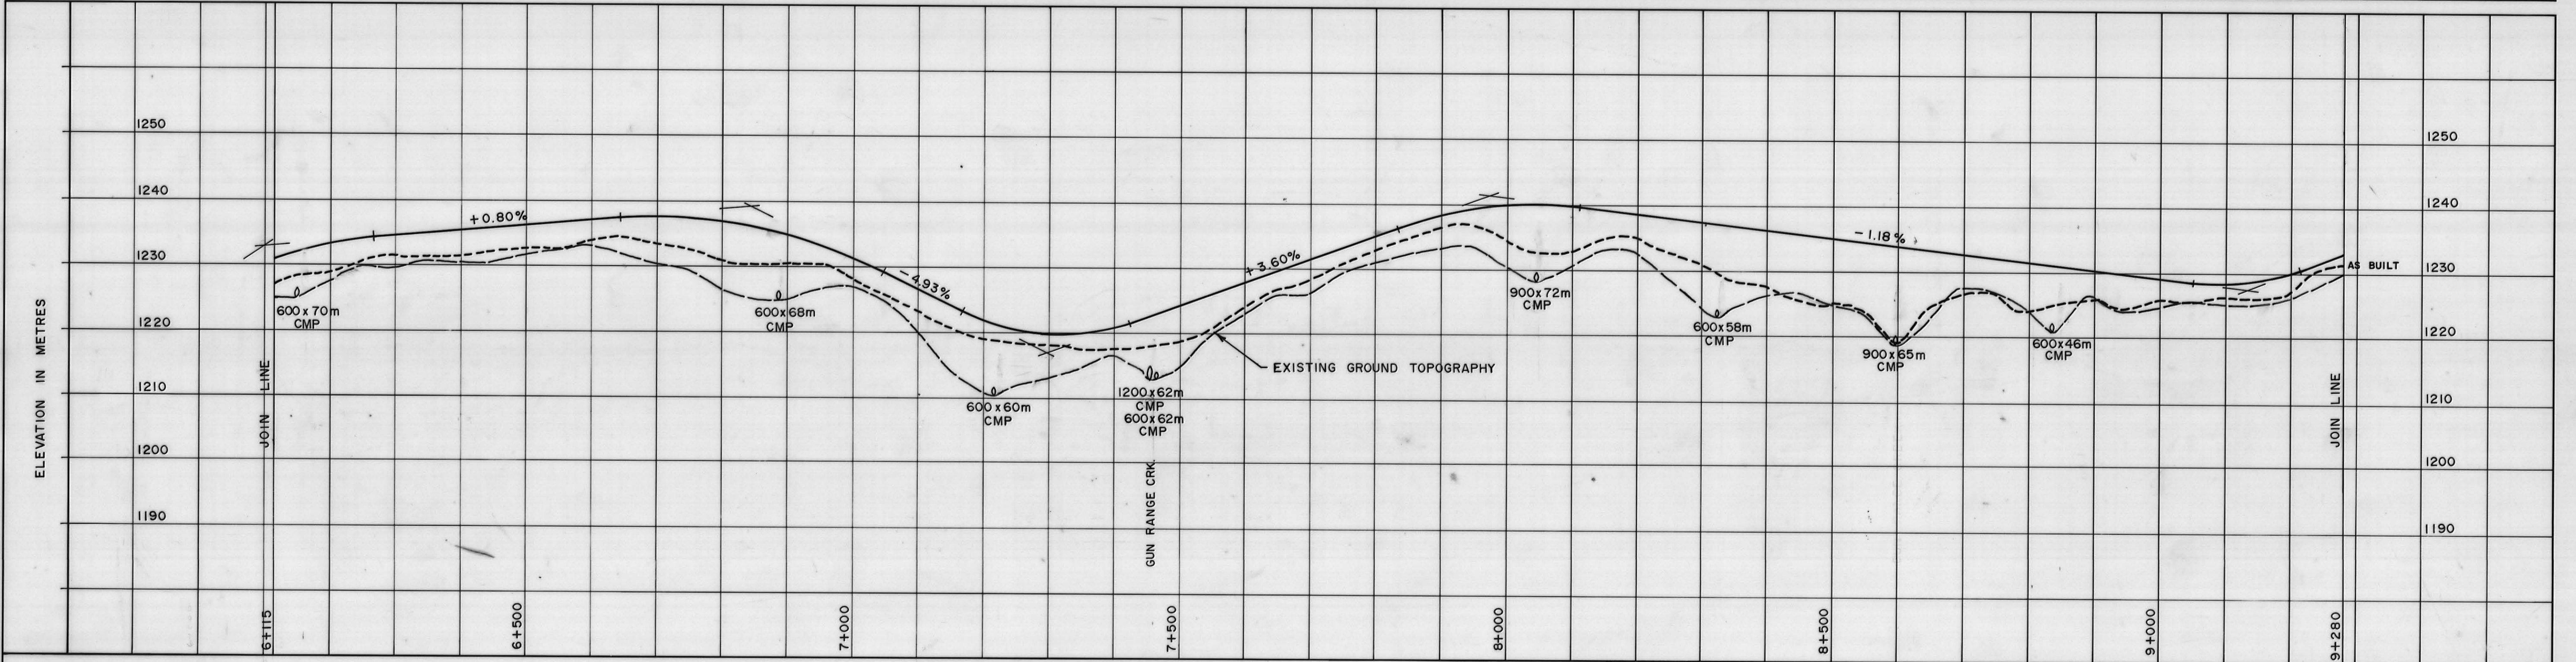


AN-VP-90-009
 Vangorda Plateau Haul Road
 Plan & Profile
 AS Built
 Fig. 2.20

007808

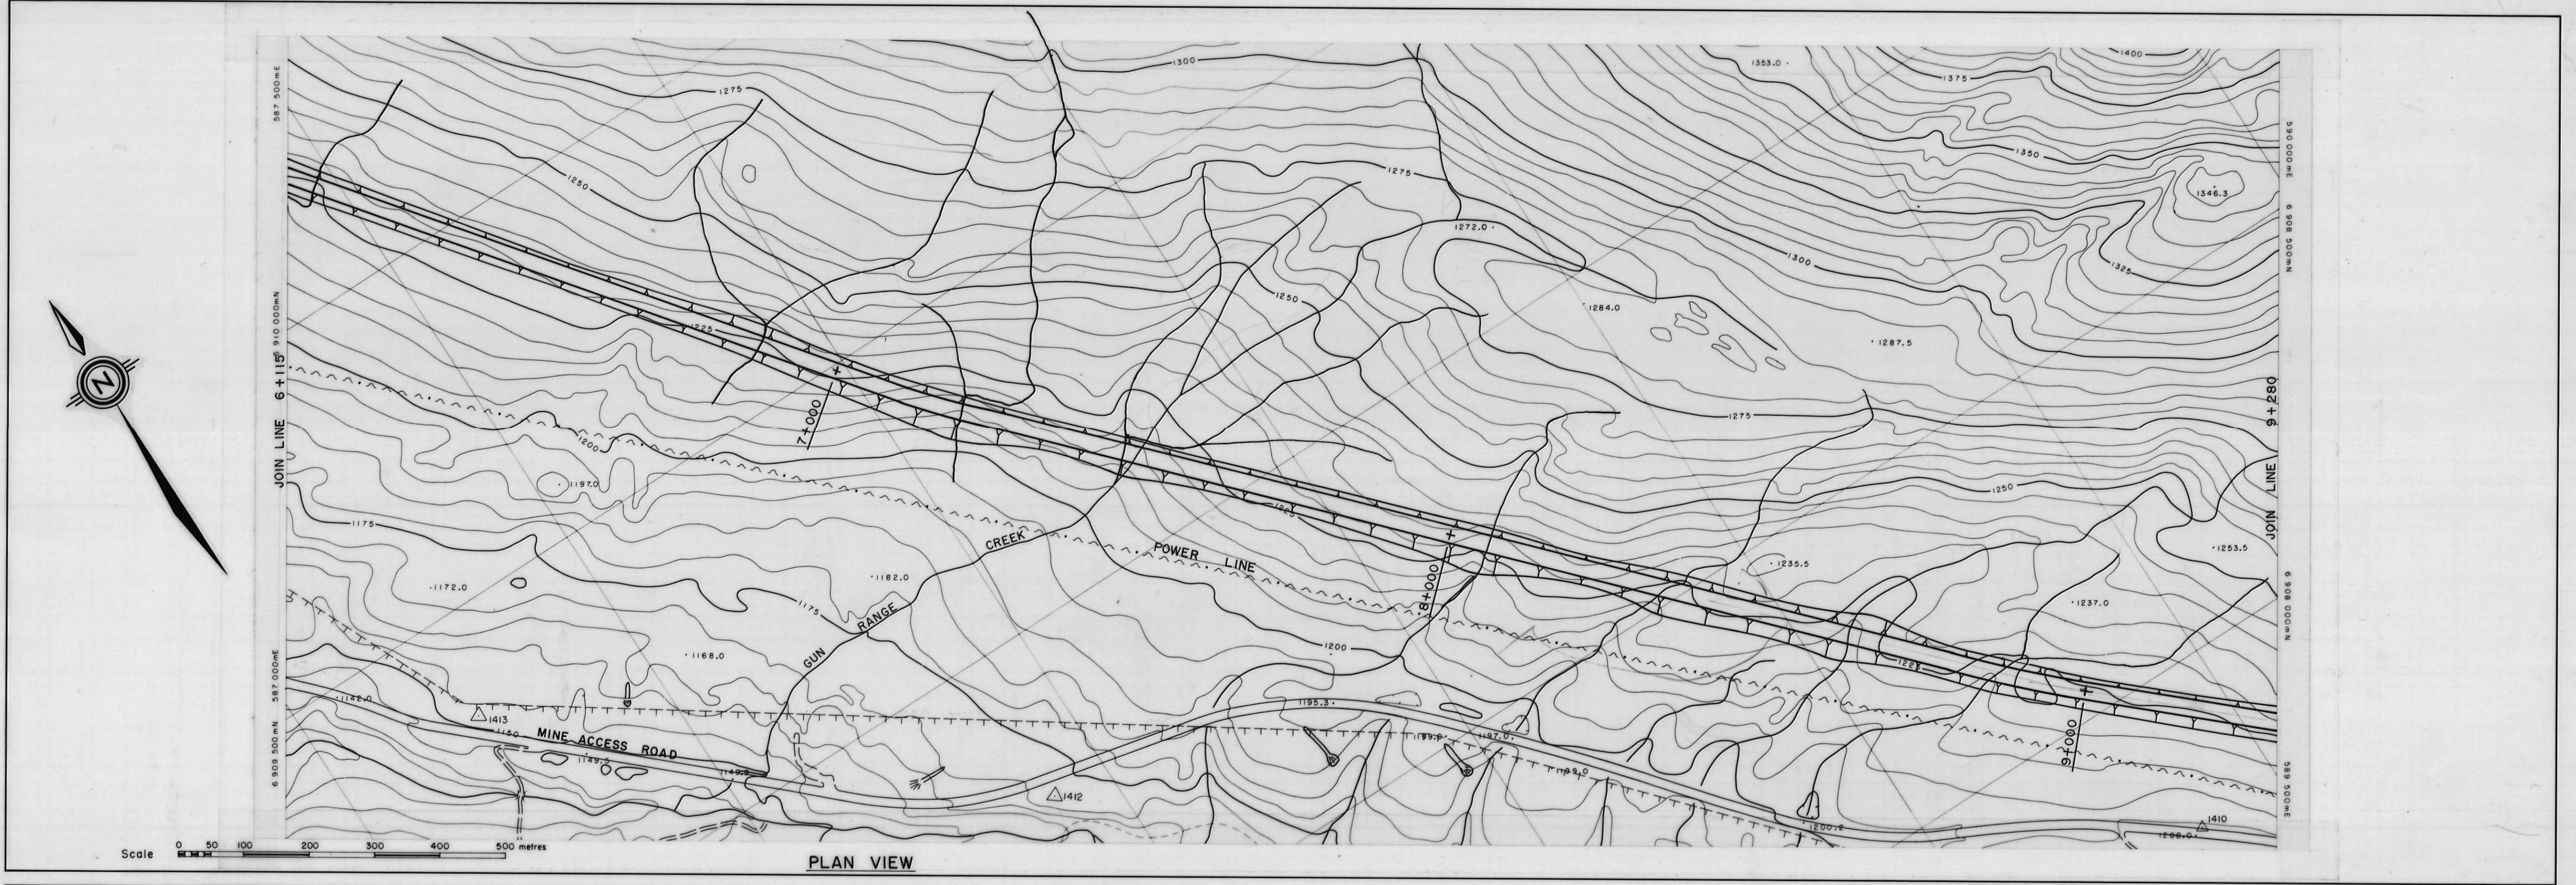

Vertical Exaggeration X 10

HORIZONTAL SCALE 0 50 100 200 300 400 500 metres

VERTICAL SCALE 0 5 10 20 30 40 50 metres

REVISED: 90/12/12

AN-VP-90-009

Corragh Resources Inc.

VANGORDA PLATEAU HAUL ROAD
 PLAN & PROFILE

STATION 6+115 to STATION 9+280

FIGURE 2.20

