
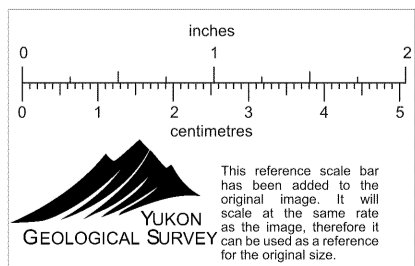


FARO U/G MINE PLAN
COMPLETION OCT 10/92

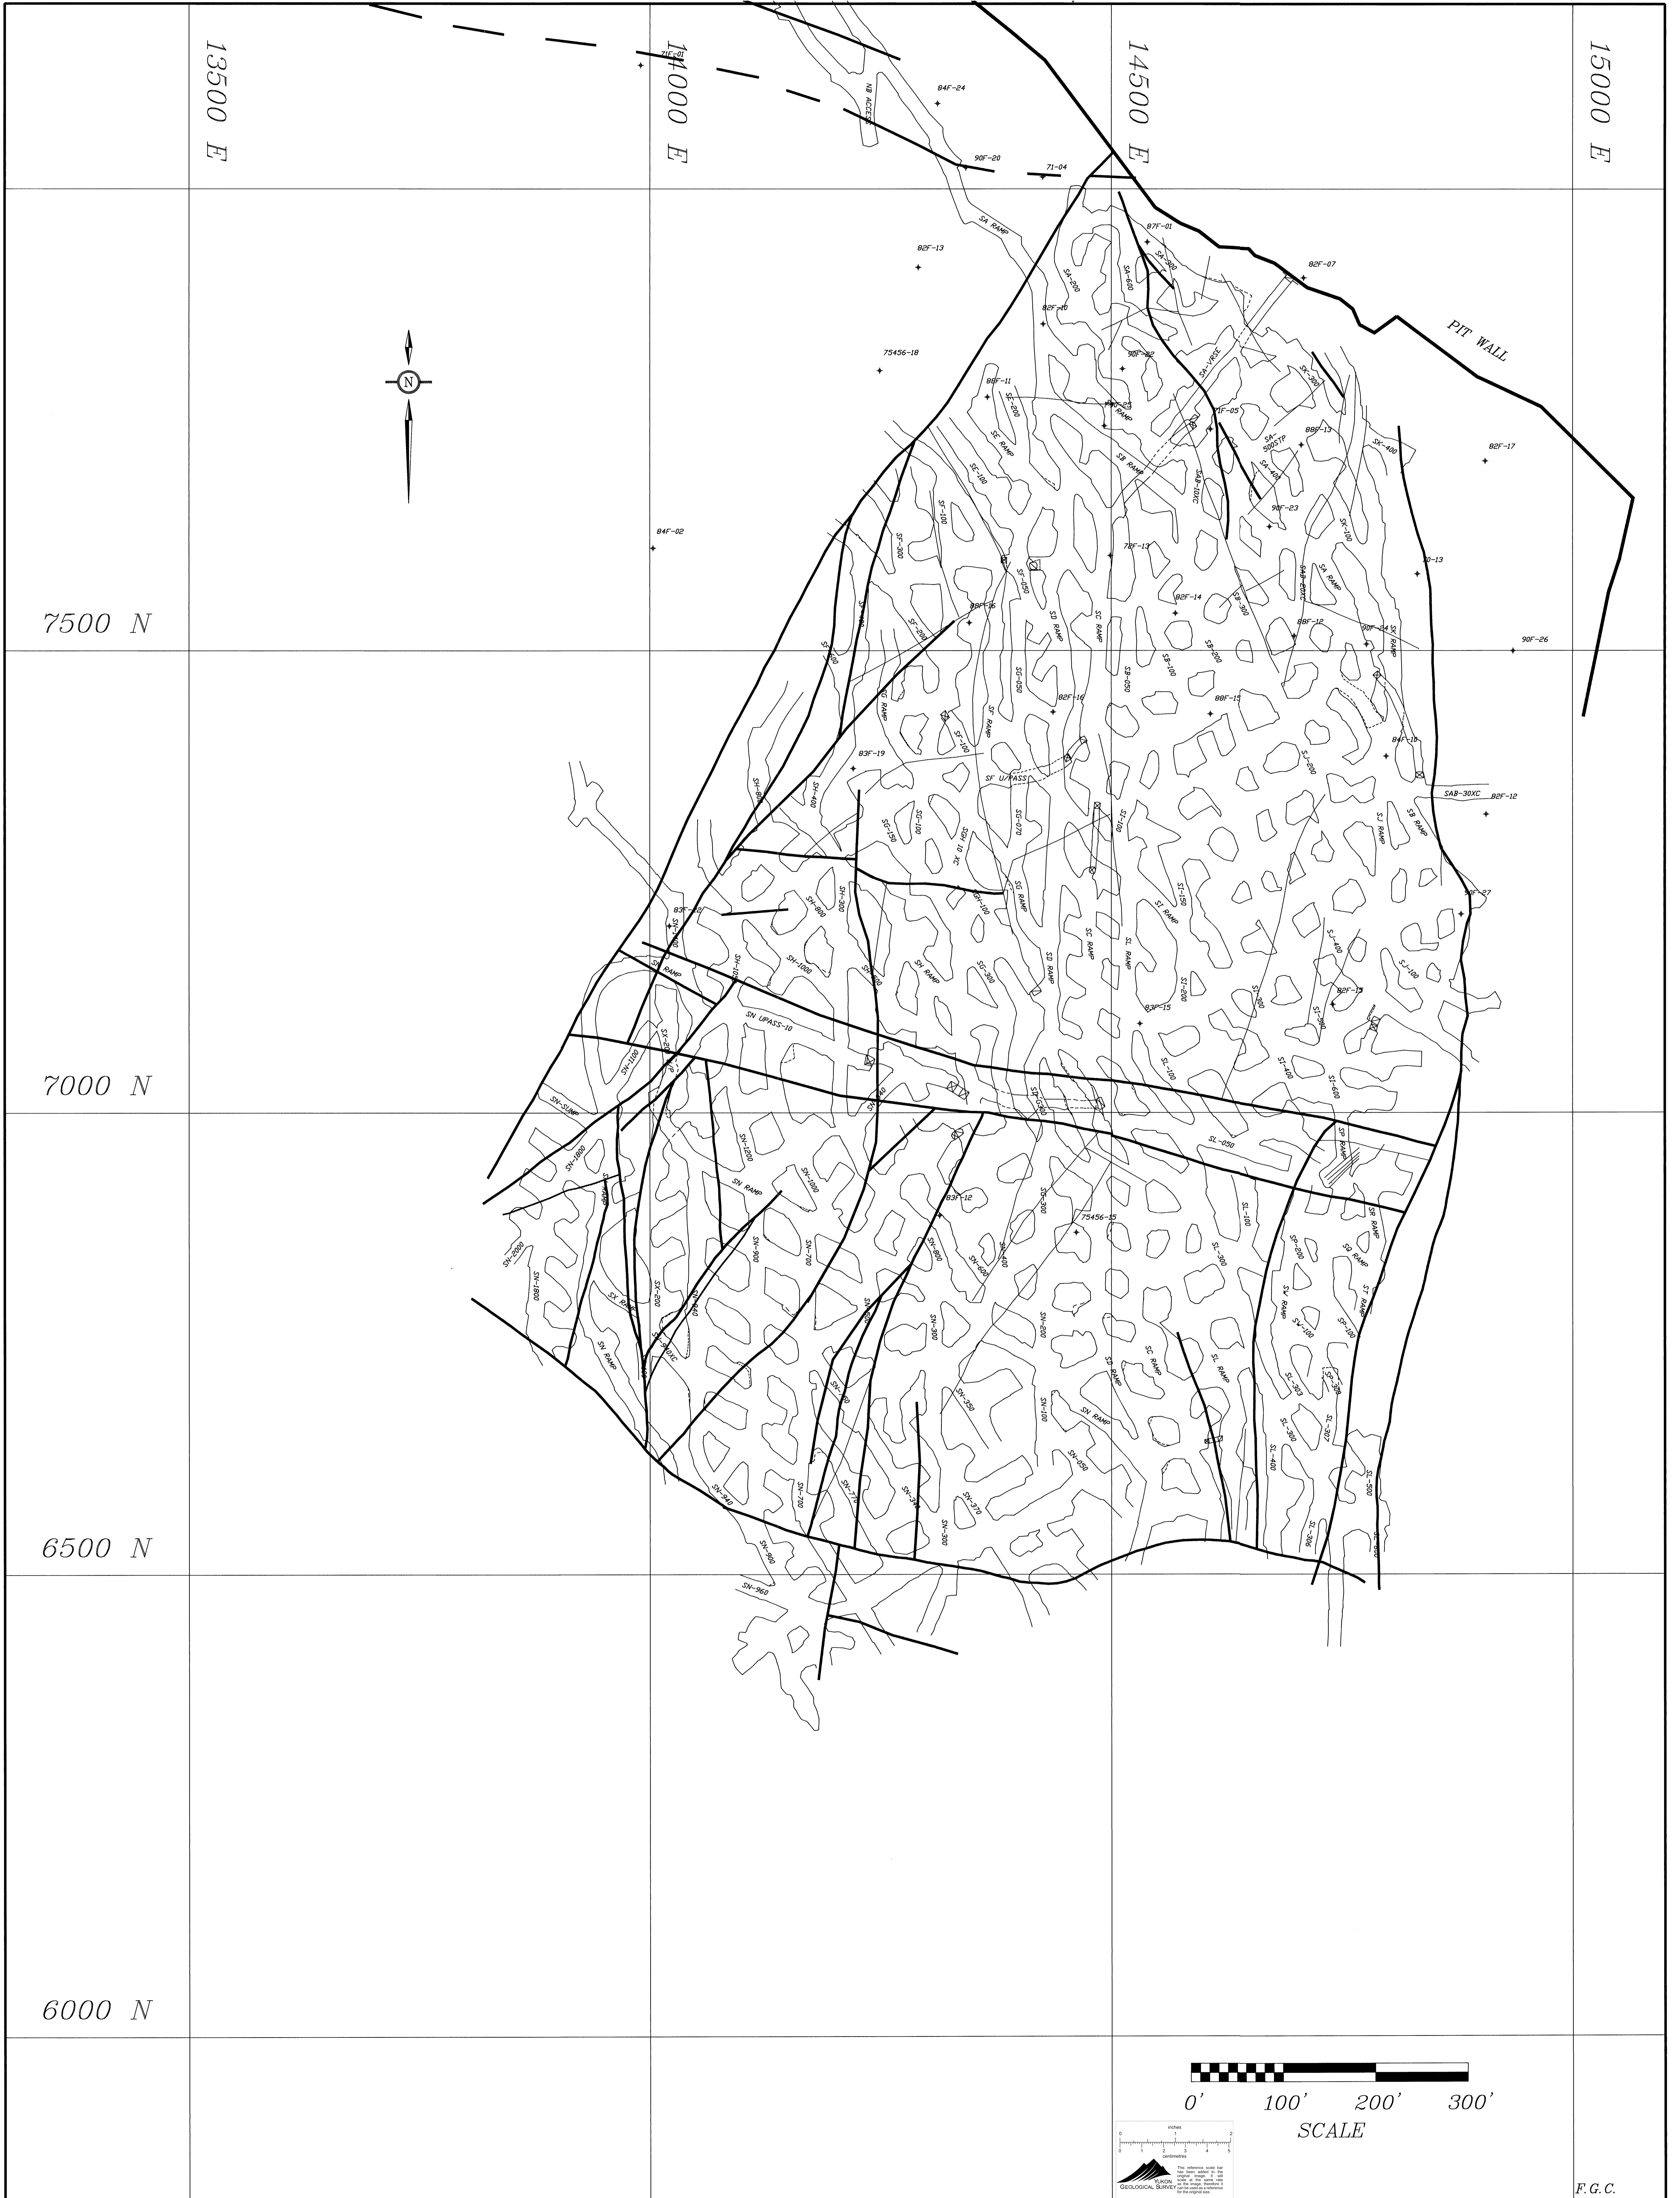

F.G.C.

CURRAGH INC.

DRAWN BY: I. BILQUIST, F.G.C.	DATE: 15/10/91
REVISED BY: I. BILQUIST, F.G.C.	DATE: 17/10/92
FILE: ASBUILT,DDH,STRUCT,TEMPLATE	AUTOCAD V.12

SCALE:
1"=60'

FARO U/G MINE PLAN
TO PROJECT COMPLETION
OCTOBER 10, 1992

PLATE:
S-1