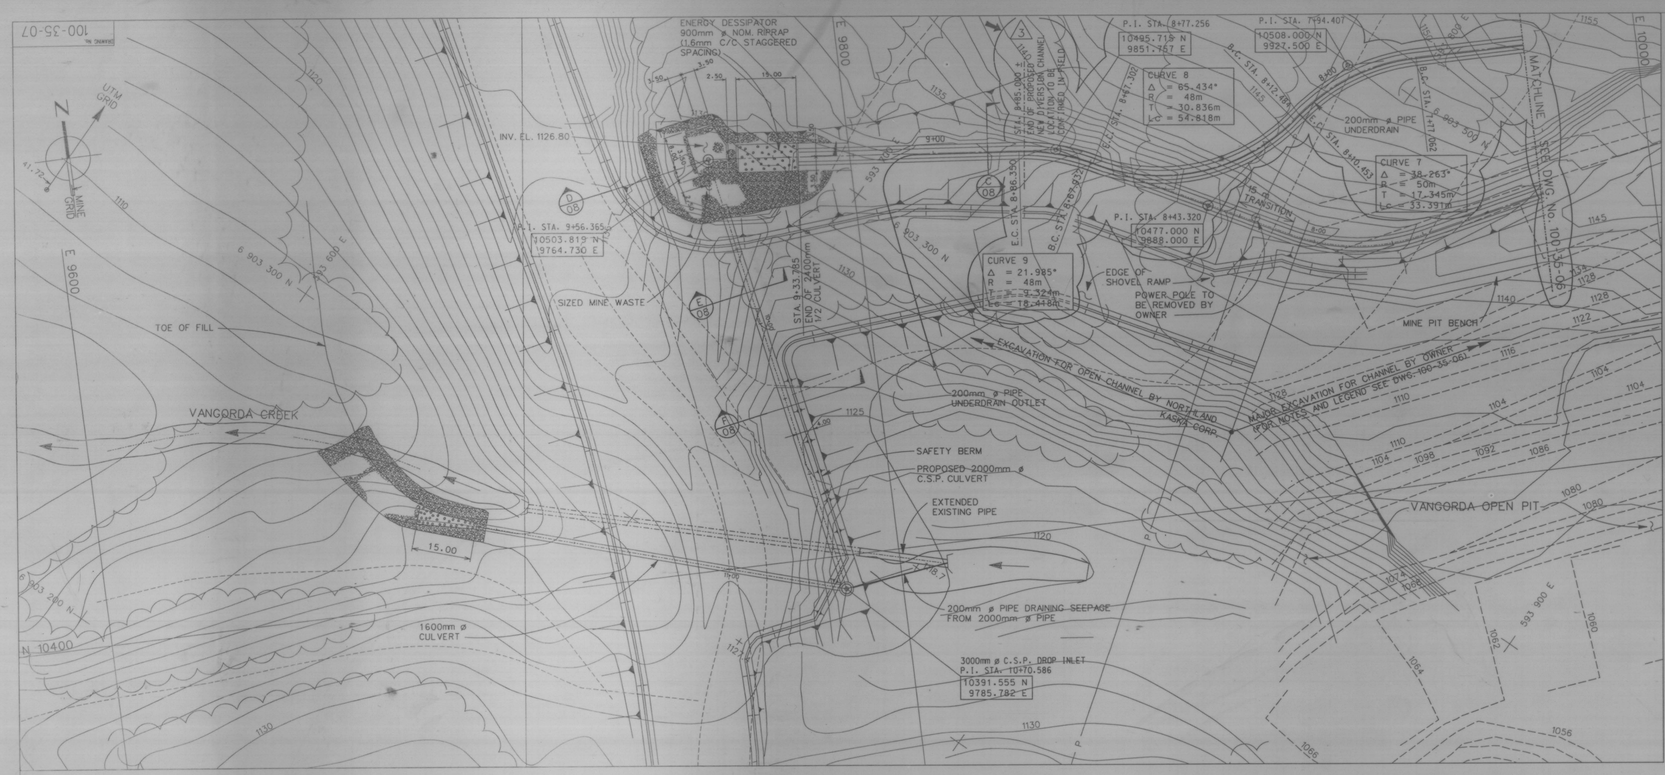

PLAN

SCALE: 1:500

NOTE:

1. AT THE LOCATION IN THE CHANNEL WHERE THE CHANNEL IS RIPRAPPED AND CONSTRUCTED IN TILL OR WITH FILL, A 15 m. LONG TRANSITION SHALL BE CONSTRUCTED UPSTREAM OF THIS LOCATION, SO THAT THE ENTIRE TRANSITION IS CONSTRUCTED IN BEDROCK AT THE UPSTREAM END, THE TRANSITION SHALL HAVE A CROSS-SECTION FOR EXCAVATION IN ROCK AND BY GRADUAL TRANSITION OVER 15 m. SHALL HAVE CROSS-SECTION FOR A RIPRAPPED CHANNEL IN EARTH AT THE DOWNSTREAM END.

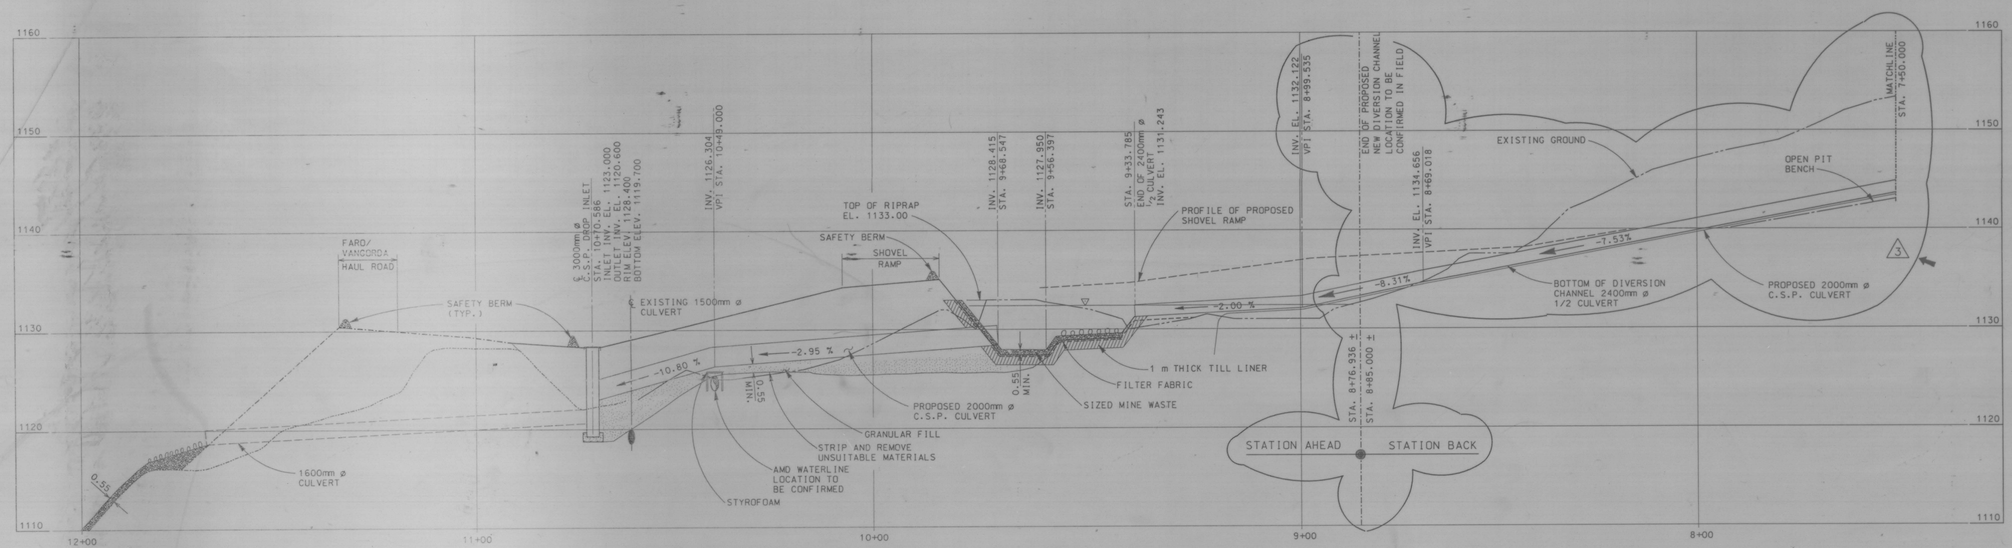

PROFILE

SCALE: HOR. 1:500m
VERT. 1:200m

JAN 23 1997
FOR COMMENTS

THE AS-BUILT INFORMATION ON THIS DRAWING IS BASED ON INFORMATION RECEIVED FROM THE CONTRACTOR. NORTHLAND KASKA CORP. AND IS THE RESPONSIBILITY OF THE CONTRACTOR.

SCALE: 1:500

SCALE: 1:200

DWG. NO.	REFERENCE DRAWINGS	DWG. NO.	REFERENCE DRAWINGS

No	DESCRIPTION	DATE	BY
3	ISSUED FOR COMMENTS	92/01/23	CHL

REVISIONS

SECTION:
SCALE: AS SHOWN DATE
DESIGNED: ARW JAN.'92
DRAWN: CHL JAN.'92
CHECKED:
APPROVED:

CLIENT: CURRAGH RESOURCES INC.
LOCATION: FARO, YUKON TERRITORY

KILBORN

TITLE
VANGORDA CREEK DIVERSION
PLAN AND PROFILE
SHEET 3

008172

1003507.DGN

ACCT. No.	
PROJECT. No.	DIVISION No.
8444	25
DRAWING NUMBER	
100-35-07	REV 3

- HF 3-309 -

AO-VA-92-020
Plan-Profile Sheet 3
Vangorda Creek Diversion
Kilborn Assoc. 100-35-07
Rev 3