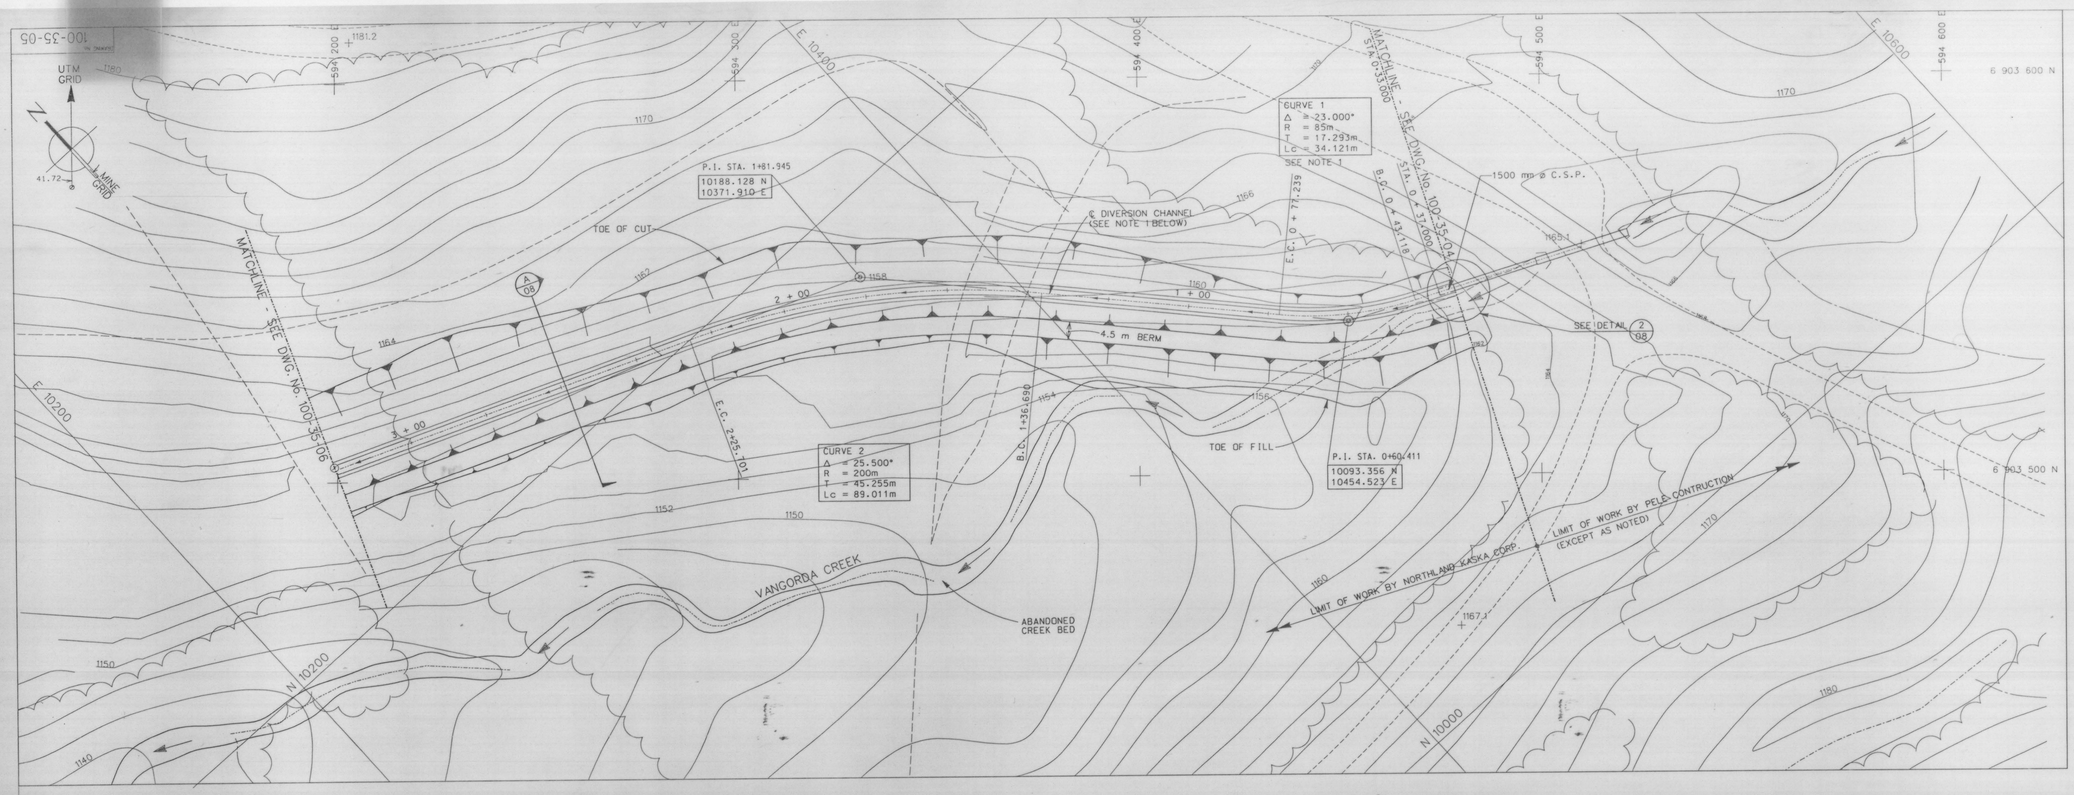

PLAN

SCALE: 1:500

NOTE:

1. FOR ALL CURVED OPEN CHANNEL SECTIONS, FABRICATION AND INSTALLATION OF HALF CULVERT FLUME SHALL BE ACCORDING TO ARMTEC DRAWINGS AND SPECIFICATIONS.

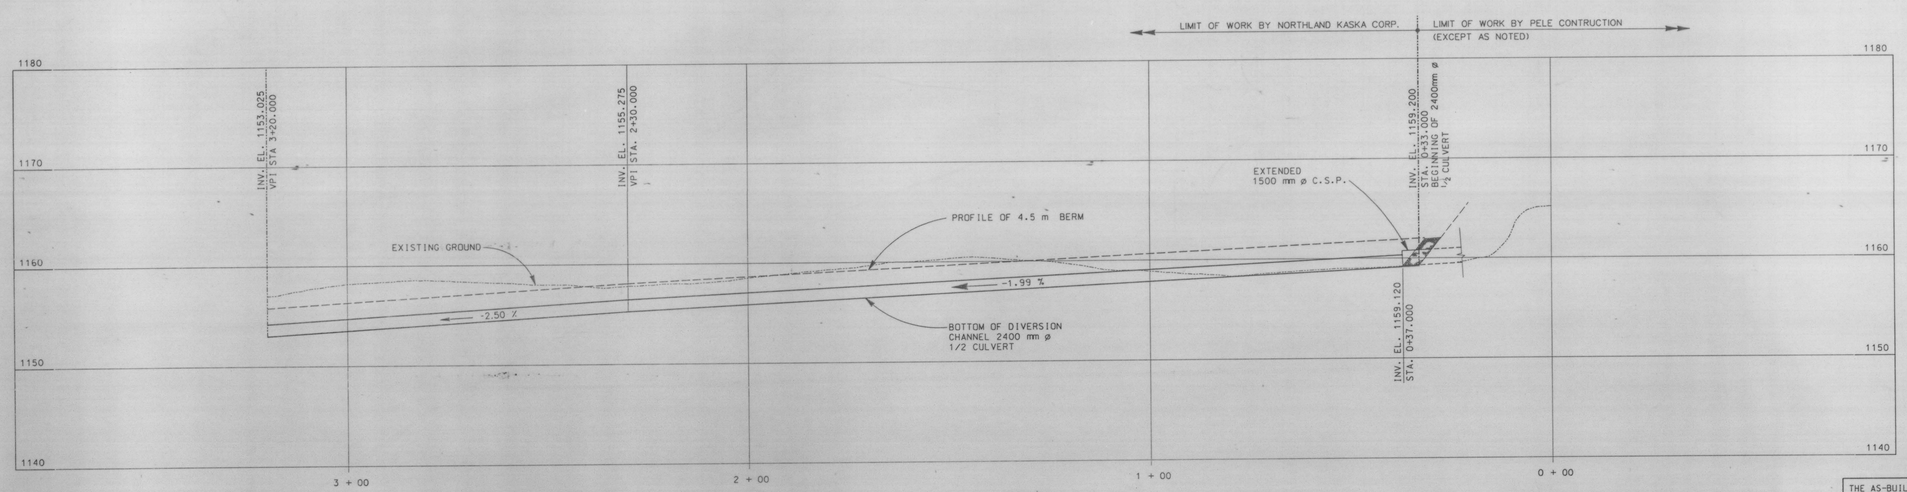

PROFILE

SCALE: HOR. 1:500
VERT. 1:200

THE AS-BUILT INFORMATION ON THIS DRAWING IS BASED ON INFORMATION RECEIVED FROM THE CONTRACTOR. NORTHLAND KASKA CORP. AND IS THE RESPONSIBILITY OF THE CONTRACTOR.

inches / centimeters — YUKON GEOLOGICAL SURVEY — This reference scale for map sizes added to the original drawing. Use the scale on this sheet to determine the map sizes on the print as a reference for the original size.

10 5 0 10 20 30 40 50 metres
SCALE: 1:500

4 2 0 4 8 12 16 20 metres
SCALE: 1:200

No	DESCRIPTION	DATE	BY
2	REVISED AS PER AS-BUILT INFORMATION RECEIVED	91/07/18	
1	REVISED AS PER CONTRACTORS AS-BUILT DWGS.	91/05/03	CHL

REVISIONS

No	DESCRIPTION	DATE	BY
O	ISSUED FOR CONSTRUCTION	91/02/01	RNJ
C	ISSUED FOR TENDER	90/12/07	RNJ
B	ISSUED FOR APPROVAL	90/11/30	RNJ
A	ISSUED FOR COMMENTS	90/11/23	RNJ

REVISIONS

SECTION: CIVIL
SCALE: AS SHOWN
DESIGNED: ARW
DRAWN: CHL/LG
CHECKED: RNJ
APPROVED: ARW
DATE: NOV.'90 / NOV.'90 / FEB.1'91

CLIENT: CURRAGH RESOURCES INC.
LOCATION: FARO, YUKON TERRITORY

KILBORN

TITLE: VANGORDA CREEK DIVERSION PLAN AND PROFILE SHEET 1

008191

1003505.DGN

ACCT. No.	
PROJECT No.	DIVISION No.
3509	30
DRAWING NUMBER	
100-35-05	REV 2

DWG. NO. | REFERENCE DRAWINGS | DWG. NO. | REFERENCE DRAWINGS

CLIENT / PROJ.MGR. / PROJ.ENG. / WET / CHECK / ELECTR. / MECH. / PNEU. / MTRL. / CONCS. / STEEL / SERVICES / ARCH. / GEN.LAB.

AU-VA-92-004
Plan + Profile Sheet 1
Vangorda Creek Diversion
Kilborn dwg 100-35-05
Rev 2
- HF3-303 -