CANADA LANDS SURVEYS RECORDS
6 6 6 0 3MC
DATE: 9 MAR 1973

PLAN AND FIELD NOTES

OF SURVEY OF

# DY 41, 43, 43A Fr., 45, 144, 183 to 186; GALE 13 AND 46; MAC 1 AND 2; MAC 1 Fr.; AND QUE 33 Fr., 32 Fr., 37 Fr., 47 Fr. MINERAL CLAIMS LOTS 1002 to 1019, QUAD 105 K/13

LATITUDE 62° 18', LONGITUDE 135° 00' (APPROX)
WHITEHORSE MINING DISTRICT
YUKON TERRITORY

SCALE 1:2500

THIS SURVEY WAS EXECUTED BY GABRIEL ALCOIN, DLS
DURING THE PERIOD OF JUNE 25 TO 29 & 7, 12, 1972
FOR CYPRUS ANVIL MINING CORPORATION

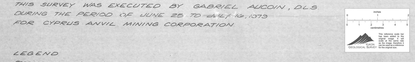


LEGEND

Bearings are astronomic derived from the bearing 110°58'00" between AY Yukon Control Monument 141 and 142 (Bearing calculated from published coordinates) F.B. 3212 & C.L.S.A. and are referred to the 135° M. Meridian of longitude.

C.L.S. 1/0 Post placed as shown thus
Cut Posts not Post Placed as shown thus

Traverse lines and stations are shown thus
Mineral claims other than by this plan are bounded thus

DISTANCES ARE IN METRES AND DECIMALS THEREOF.

Cut stations marked on Station posts are in Red.

I, Gabriel Alcoin, of the City of Whitehorse, Canada Lands Surveyor, make oath and say that I have in my employ Canada Lands Surveyors, no one and the surveying of the Surveyor General of Canada Lands, authority, actually executed the survey shown by this plan and field notes, and that the field notes of the survey shown on this plan are correct and true to the best of my knowledge and belief so help me God.

Sworn before me at Whitehorse
this 9 day of March, 1973

A Notary Public in and for the Yukon Territory

Canada Lands Surveyor

I, hereby certify that I have carefully examined the ground included in DY 41, 43, 43A Fr., 45, 144, 183 to 186; GALE 13 and 46; MAC 1 and 2; MAC 1 Fr.; and QUE 33 Fr., 32 Fr., 37 Fr., 47 Fr. mineral claims, surveyed by me, and that I have intentionally made all reasonable investigations in my power to ascertain if there was any other existing mineral, coal, petroleum, oil, natural gas, or other mineral rights, or any other rights, which would have to be reserved, or information of any such claim except as follows: None.

Canada Lands Surveyor

Department of Energy, Mines and Resources
Classes 19 August 1972
Re: Section 10 Yukon Quartz Mining Act
Approved
W. Pelletier
Director General

INSCRIPTIONS FOUND ON LOCATION POSTS

| Post | Post Markings |
|---|---|
| 1 | LP No 1 — Reg No 47320<br>LP No 1 — Reg No 47319<br>LP No 1 — Reg No 47321<br>LP No 1 — BOB 1<br>LP No 2 — Reg No 46892 |
| 2 | LP No 1 — MAC 1 Fr. Bi Metal Aug 26,1971 South 200' E 1500<br>LP No 2 — TIM 6Fr. Bi Metal Aug 26,1971<br>2 L.P.'s — no m.k. — Reg No 47170 |
| 3 | LP No 1 — TIM 6Fr. Bi Metal Aug 26,1971 North 200' W 1500<br>LP No 1 — Reg No 47172<br>LP No 2 — MAC 1Fr. Bi Metal Aug 26,1971 North 200' — Reg No 47320<br>LP No 2 — Reg No 46735<br>LP No 2 — Reg No 46720 |
| 4 | LP No 1 — Reg No 46736<br>LP No 1 — Reg No 47346<br>LP No 2 — Reg No 47380<br>LP No 2 — Reg No 46734<br>LP No 2 — Reg No 46721<br>LP — No Reg |
| 5 | LP No 1 — Reg No 47334<br>LP No 1 — Reg No 47333<br>LP No 1 — BOB 13 Oct 15, 1969 — Reg No 46727<br>LP No 2 — Reg No 47332<br>LP No 2 — Reg No 47331<br>2 L.P.'s — No Reg |
| 6 | LP No 1 — Reg No 47381<br>LP No 1 — Reg No 47382<br>LP No 2 — Reg No 46739<br>LP No 2 — Reg No 46728<br>LP No 2 — Reg No 46729<br>2 L.P.'s |
| 7 | LP No 1 — Reg No 46738<br>LP No 1 — Reg No 35-113<br>LP No 2 — Reg No 35-114<br>LP No 2 — Reg No 46736<br>LP No 2 — Reg No 35-112<br>LP No 2 — Reg No 46735<br>LP — No Reg |
| 8 | LP No 1 — Reg No 47343<br>LP No 1 — Reg No 46780<br>LP No 1 — Reg No 46781<br>LP No 1 — Reg No 46725<br>LP No 1 — Reg No 35-114<br>LP No 1 — Reg No 46729<br>LP No 2 — Reg No 46784<br>LP No 2 — Reg No 46787 |
| 9 | LP No 1 — LAKE 20 Nov 8, 1963 South 1500' R<br>LP No 1 — LAKE 21 Nov 8, 1963 South 1500' L<br>LP No 2 — LAKE 19 Nov 8, 1963<br>LP No 1 — Reg No 47345<br>LP No 2 — Reg No 47344<br>LP No 2 — Reg No 47343 |
| 10 | LP No 1 — Reg No 46788<br>LP No 1 — Reg No 46789<br>LP No 2 — Reg No 47349<br>LP No 2 — Reg No 47348<br>LP No 2 — Reg No 47347<br>LP No 2 — Reg No 47346 |
| 11 | LP No 1 — Reg No 46928<br>LP No 1<br>LP No 2 — Reg No 46926<br>LP No 2 — Reg No 46927 |
| 12 | LP No 1 — Reg No 46924<br>LP No 1 — Reg No 46927<br>LP No 2 — Reg No 46926<br>LP No 2 — Reg No 46925<br>LP No 2 — Reg No 46923<br>LP No 2 — Reg No 46922<br>L.P. — no Reg |
| 13 | LP No 1 — DY 43A Fr. G. Nixon July 20, 1972 NW 1500, 1500<br>LP No 2 — DY 44 Fr. G. Nixon July 20, 1972 NW 1500, 1500<br>LP No 2 — DY 43 Fr. G. Nixon July 20, 1972 NW 1500, 1500<br>LP No 2 — Reg No 46933 |
| 14 | LP No 1 — Reg No 46925<br>LP No 1 — Reg No 46924<br>LP No 2 — Reg No 46921<br>LP No 2 — Reg No 46923 |
| 15 | LP No 1 — Reg No 46921<br>LP No 1 — Reg No 46922<br>LP No 2 — Reg No 46923<br>LP No 2 — Reg No 35-108<br>LP No 2 — Reg No 35-110<br>LP No 2 — Reg No 35-111 |
| 16 | LP No 1 — Reg No 47344<br>LP No 2 — Reg No 47349<br>LP No 2 — Reg No 47348<br>LP No 1 — LAKE 18 Nov 8, 1963 North 1500 L<br>2 L.P.'s |
| 17 | LP No 1 — Reg No 46921<br>LP No 1 — Reg No 46922<br>LP No 1 — Reg No 35-108<br>LP No 2 — Reg No 35-109<br>LP No 2 — Reg No 35-105<br>LP No 2 — Reg No 35-106 |
| 18 | LP No 1 — Reg No 47347 |
| 19 | LP No 1 — Reg No 47348<br>LP No 1 — Reg No 47349<br>LP No 2 — Reg No 47350<br>LP No 2 — Reg No 47351 |

NOTE:
No evidence of Lg 182 and Lg 183 was found. A Posts and Stating Stakes confirm

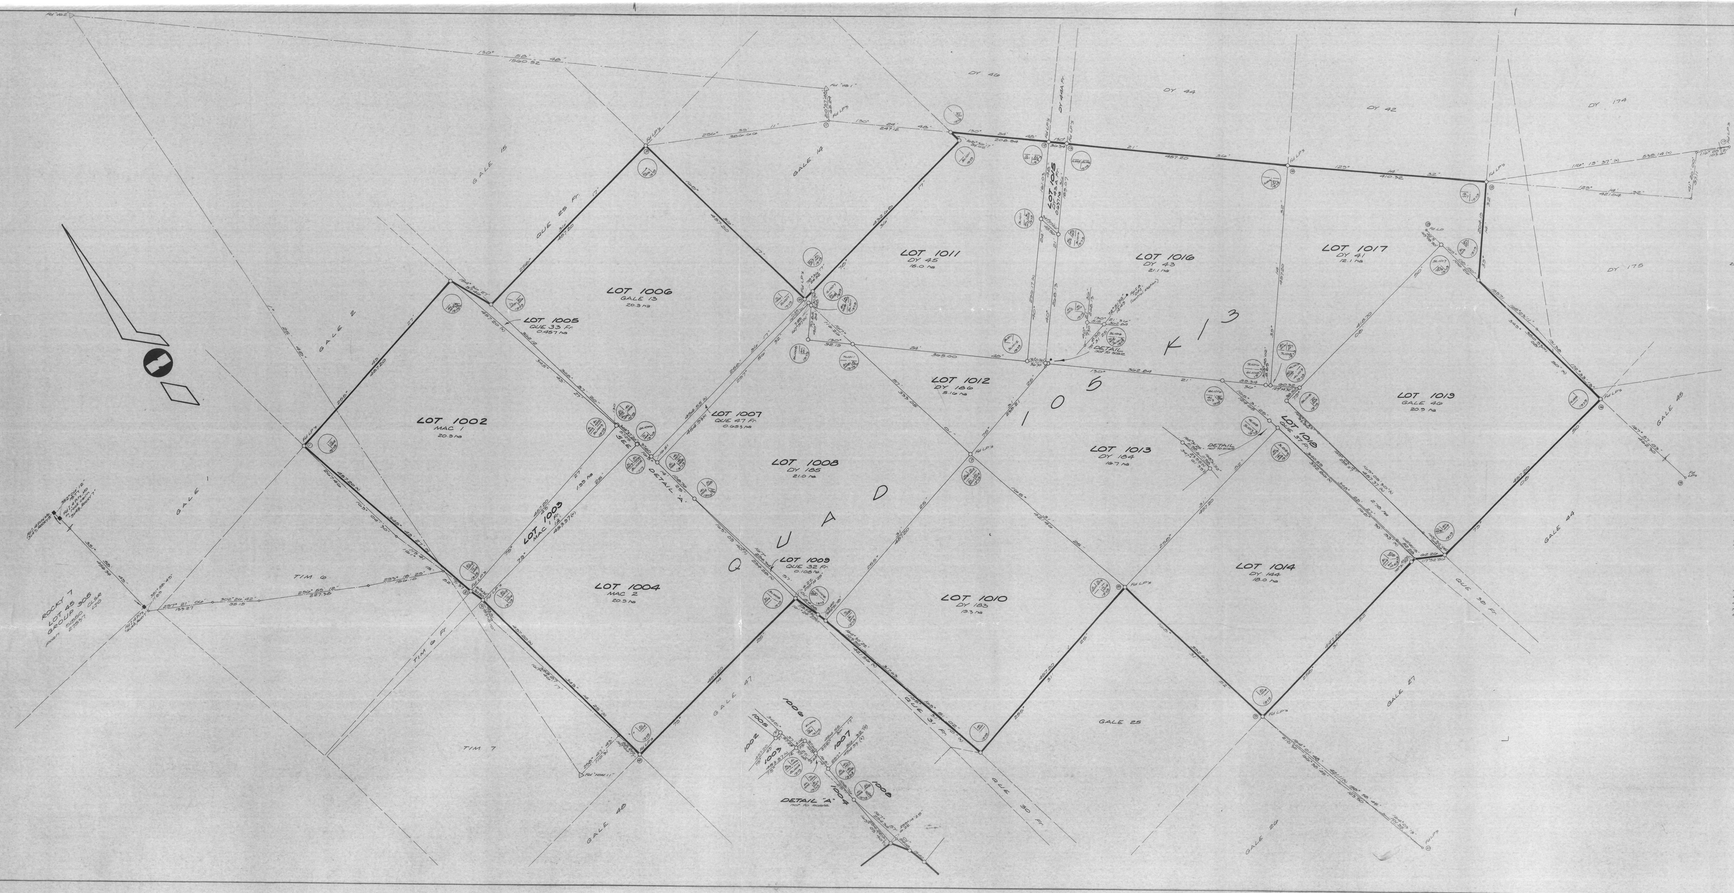


Hardman Jones, Milne and Associates Limited
Land Surveyors, Whitehorse, Yukon Territory

CMB 8 Canada Lands Surveys Records

015067