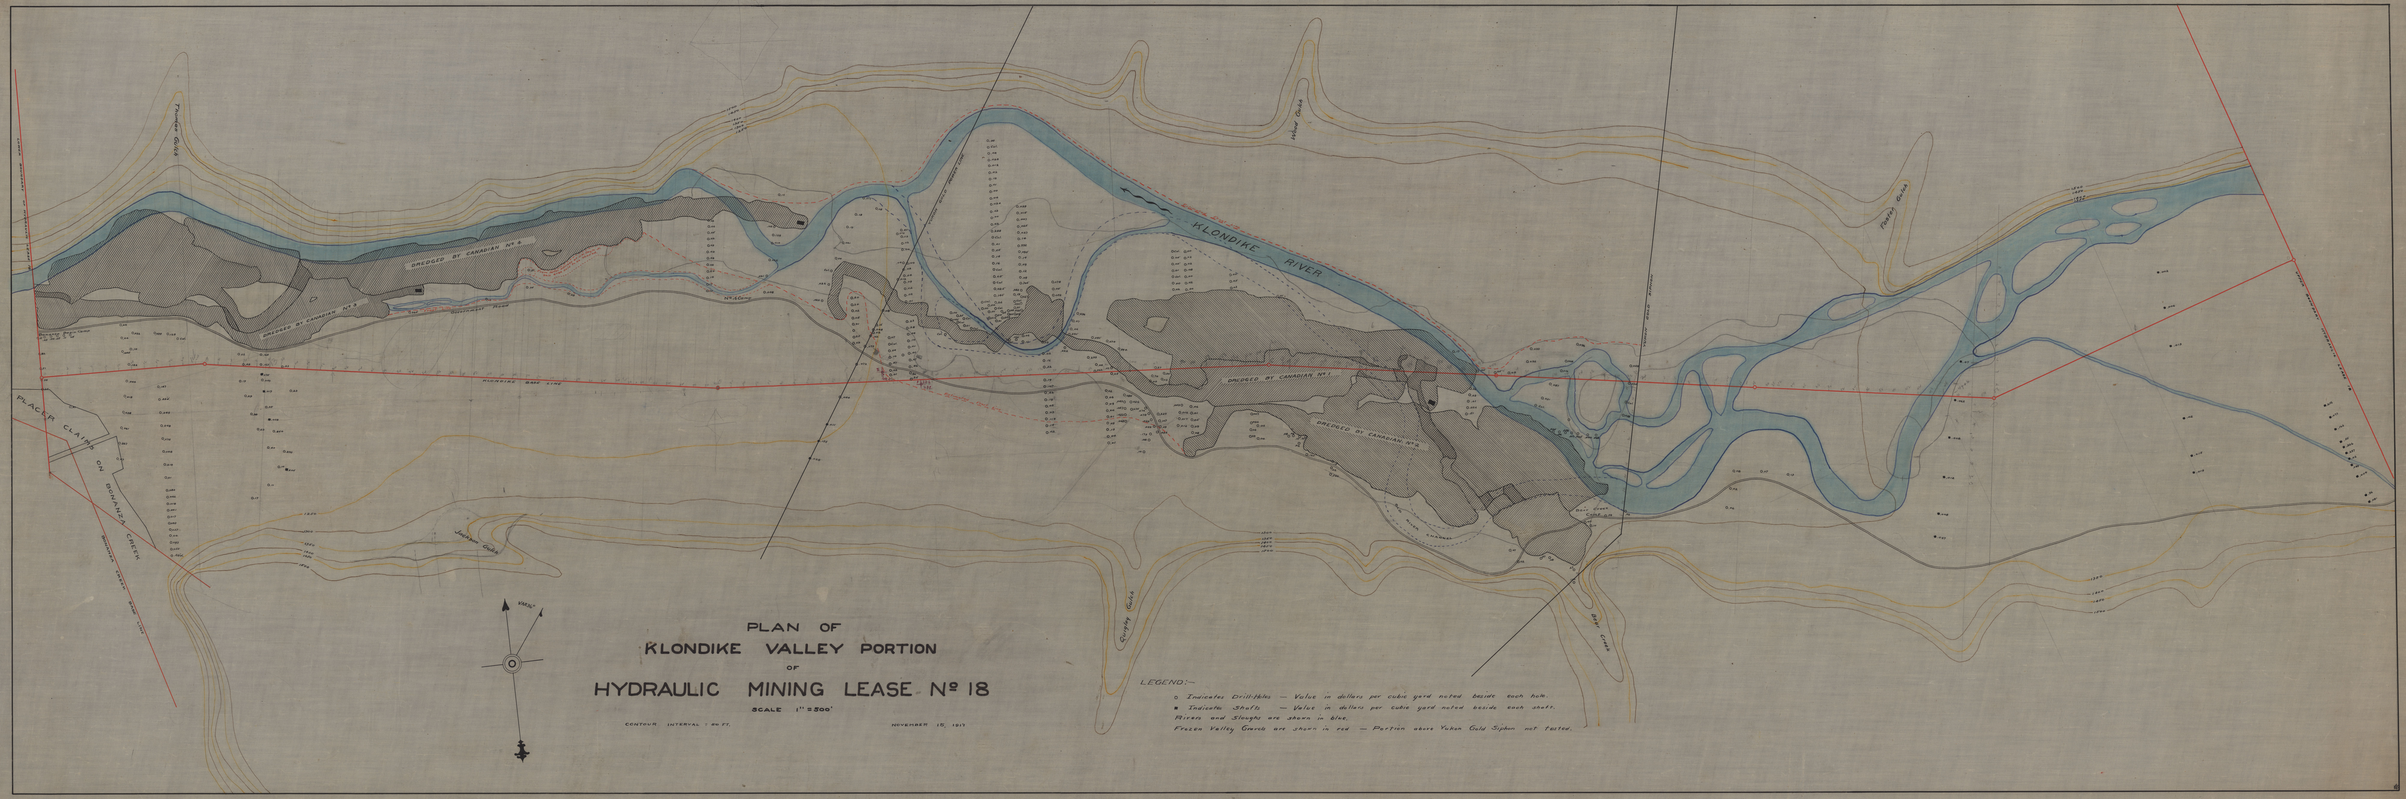
PLAN OF
KLONDIKE VALLEY PORTION
OF
HYDRAULIC MINING LEASE Nº 18
SCALE 1" = 200'
CONTOUR INTERVAL = 20 FT.
NOVEMBER 15, 1917
KLONDIKE RIVER
DREDGED BY CANADIAN Nº 1
DREDGED BY CANADIAN Nº 2
DREDGED BY CANADIAN Nº 3
DREDGED BY CANADIAN Nº 4
DREDGED BY CANADIAN Nº 6
PLACER CLAIMS ON BONANZA CREEK
KLONDIKE BASE LINE
Thunder Gulch
Wood Gulch
Foster Gulch
Quigley Gulch
Bear Creek
LEGEND:—
Indicates Drill-Holes — Value in dollars per cubic yard noted beside each hole.
Indicates Shafts — Value in dollars per cubic yard noted beside each shaft.
Rivers and Sloughs are shown in blue.
Frozen Valley Gravels are shown in red — Portion above Yukon Gold Siphon not tested.

e011156227